

LINCOLN
 K 16
 8-1-73

MISSISSIPPI
 BOARD OF WATER COMMISSIONERS
 416 North State Street
 Jackson, Mississippi 39201

CODED

WATER WELL DRILLERS LOG

1 Aug 1973
 date well completed

American Well Service Lincoln
 firm name county well located

LANDOWNER:

MARSHALL Smith

(mailing address)

WELL LOCATION:

sec 32 T 6 N R 6 E
 5 miles South of West Lincoln
 (distance) (direction) (nearest town)

WELL PURPOSE:

(home, irrigation, municipal, industrial)

WELL COMPLETION DATA:

- (1) diameter (inches) 4
- (2) total depth (feet) 80
- (3) static water level (feet) 60 below top of ground.
- (4) casing (material) PL (depth) 74
- (size) if telescope see back.
- (5) screen (length) 6 (depth to top) 74
- (size) 4 (material) PL
- (6) pump (HP) 1/2 (yield gpm) 8
- (type power) electric
- (7) electric log (yes or no)
- (organization running log)
- (8) how well bottom plugged used

description of formations encountered

from to

Clay dirt	0	15
Chalk	15	42
sand & Pen Gravel	42	50
Chalk	50	55
sand Pen Gravel	55	80


CODED

DRILLERS REMARKS:

WET 8 1973

If well telescopes please sketch and show depths.

GROUND LEVEL

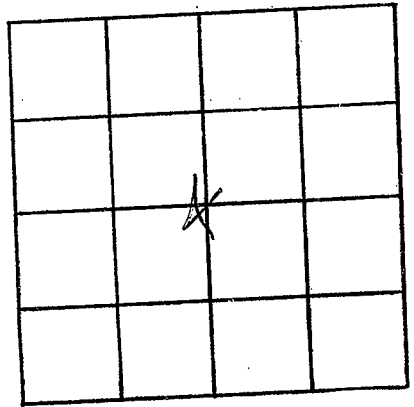

SECTION 22

Please indicate well location X.

ADDITIONAL INFORMATION

If more than one screen, show locations of each on sketch.