

LINCOLN
K 17
1-16-74

MISSISSIPPI
BOARD OF WATER COMMISSIONERS
416 North State Street
Jackson, Mississippi 39201

CODED

WATER WELL DRILLERS LOG

16 Jan 1974 # J.T. Livingston Lincoln
date well completed firm name county well located


LANDOWNER:	description of formations encountered	from	to
Martin Sisco B.C. Miss. (mailing address)			
WELL LOCATION:			
sec 35 T 6 N R 6 E 6 miles N of Auburn (distance) (direction) (nearest town)			
WELL PURPOSE: (home, irrigation, municipal, industrial)			
WELL COMPLETION DATA:			
(1) diameter (inches) 4 1/4			
(2) total depth (feet) 114			
(3) static water level (feet) 70 below top of ground.			
(4) casing 4" (material), 107' (depth)			
(size) if telescope see back.			
(5) screen 6" (length), 107' (depth to top)			
4" (size), 4" (material)			
(6) pump (HP) (yield gpm)			
(type power)			
(7) electric log (yes or no)			
(organization running log)			
(8) how well bottom plugged wood			
DRILLERS REMARKS:			

FEB 19 1974

MISS. Bd. OF WATER COMMISSIONERS

If well telescopes please sketch and show depths.

GROUND LEVEL

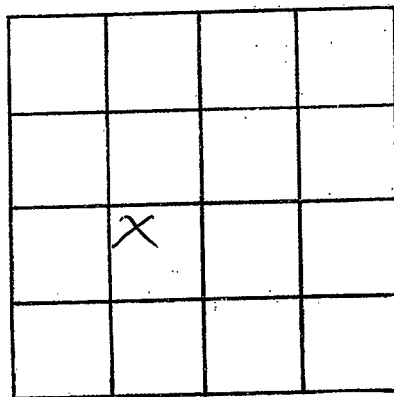

SECTION 35

Please indicate well location X.

ADDITIONAL INFORMATION

If more than one screen, show locations of each on sketch.