

LINCOLN
K 18
4-30-74

MISSISSIPPI
BOARD OF WATER COMMISSIONERS
416 North State Street
Jackson, Mississippi 39201

CODED

WATER WELL DRILLERS LOG

30 April 1974 J.T. Conroy & Son Landownr
date well completed firm name county well located


LANDOWNER:	description of formations encountered	from	to
McComb Landownr	Clay	0	25
McComb	Clay	25	45
(mailing address)	1900' chert	45	65
WELL LOCATION:	Sand	65	94
sec 35 T. 6 N R. 6 E			
6 miles W of Hudson			
(distance) (direction) (nearest town)			
WELL PURPOSE:			
(home, irrigation, municipal, industrial)			
WELL COMPLETION DATA:			
(1) diameter (inches) 4			
(2) total depth (feet) 94			
(3) static water level (feet) 80 below top of ground.			
(4) casing 1" 88 (material) (depth)			
(size) if telescope see back.			
(5) screen 6" 88 (length) (depth to top)			
4" (size) (material)			
(6) pump 1/2 HP 8 (yield gpm)			
2HP (type power)			
(7) electric log (yes or no)			
(organization running log)			
(8) how well bottom plugged wood			
DRILLERS REMARKS:			

CODED

RECEIVED
MAY 1 1974
MISS. Bd. of Water Comm.

If well telescopes please
sketch and show depths.

GROUND LEVEL

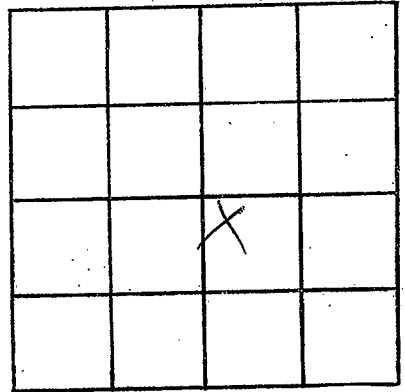

SECTION 35

Please indicate well location X.

ADDITIONAL INFORMATION

If more than one screen,
show locations of each on sketch.