

LINCOLN  
K 19  
5-8-74

MISSISSIPPI  
BOARD OF WATER COMMISSIONERS  
416 North State Street  
Jackson, Mississippi 39201

WATER WELL DRILLERS LOG

May 8 1974 Grenn Water well Cont. Lincoln  
date well completed firm name county well located

LANDOWNER: Johnny Wallace  
Rt. 5, Brookhaven, Miss.

description of formations encountered

from to

Red clay	1	25
sand & gravel	25	30
white clay	30	104
<del>fine sand</del> blue clay	104	120
fine sand	120	140
medium sand	140	150
coarse sand small gravel	150	158

(mailing address)

WELL LOCATION:

sec. 4 T 6 N R 6 E

10 miles W of Brookhaven  
(distance) (direction) (nearest town)

WELL PURPOSE: home  
(home, irrigation, municipal, industrial)

WELL COMPLETION DATA:


- (1) diameter (inches) 6"
- (2) total depth (feet) 158
- (3) static water level (feet) 100 below top of ground.
- (4) casing PVC, 152 (material), (depth)  
4" (size) If telescope see back.
- (5) screen 6" 152" (length), (depth to top)  
.010 PVC (size) (material)
- (6) pump 1/2 sub 7 (HP) (yield gpm)  
electric (type power)
- (7) electric log no (yes or no)  
(organization running log)
- (8) how well bottom plugged wood

DRILLERS REMARKS:

DECEMBER 1974  
MISS. Bd. OF WA

If well telescopes please sketch and show depths.

GROUND LEVEL

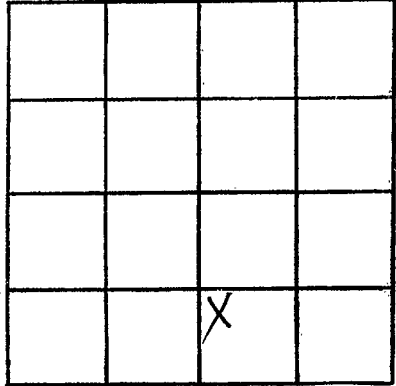

SECTION 4

Please indicate well location X.

ADDITIONAL INFORMATION

If more than one screen, show locations of each on sketch.