

LINCOLN
K 20
10/23/74

MISSISSIPPI
BOARD OF WATER COMMISSIONERS
416 North State Street
Jackson, Mississippi 39201

CODED

WATER WELL DRILLERS LOG

10/23/74 date well completed Chester Keener firm name Lincoln county well located

LANDOWNER: Sam Star
Producing Co-
Trinidad, Texas
(mailing address)

description of formations encountered	from	to
<u>Sandy clay</u>	<u>0</u>	<u>16</u>
<u>Blue clay</u>	<u>16</u>	<u>105</u>
<u>Orange sand</u>	<u>105</u>	<u>122</u>

WELL LOCATION:
sec. 9 T 6 N R. 4 E
11 miles SW Brookhaven
(distance) (direction) (nearest town)

WELL PURPOSE: Industrial
(home, irrigation, municipal, industrial)

- WELL COMPLETION DATA:
- (1) diameter (inches) 4"
 - (2) total depth (feet) 122
 - (3) static water level (feet) 43 below top of ground.
 - (4) casing Plast Ballam
(material) (depth)
 - (5) screen 6' 116
(length) (depth to top)
 - 4" Plast
(size) (material)
 - (6) pump 1/2 15
(HP) (yield gpm)
 - Shut
(type power)
 - (7) electric log NO
(yes or no)
 - (organization running log)

(8) how well bottom plugged
wooden plug

DRILLERS REMARKS:
New location


CODED

RECEIVED
NOV 18 1974

MISS. RD. OF WATER COMM

If well telescopes please sketch and show depths.

GROUND LEVEL

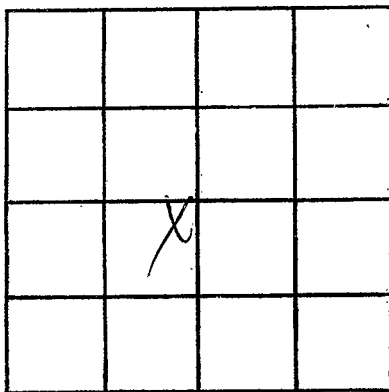

SECTION 9

Please indicate well location X.

ADDITIONAL INFORMATION

If more than one screen,
show locations of each on sketch.