

Lincoln  
K21  
9-20-74

MISSISSIPPI  
BOARD OF WATER COMMISSIONERS  
416 North State Street  
Jackson, Mississippi 39201

WATER WELL DRILLERS LOG

RECORDED

Sept 20 1974 Chester Keener Lincoln  
date well completed firm name county well located

LANDOWNER: Edward  
Smith  
RFD Brookhaven  
(mailing address)

description of formations encountered	from	to
clay gravel	0	14
sand gravel	14	58
blue chalky	58	141
coarse sand	141	153

WELL LOCATION:  
sec. 4 T. 6 N. R. 6 E.  
10 miles SW of Brookhaven  
(distance) (direction) (nearest town)

WELL PURPOSE: same  
(home, irrigation, municipal, industrial)

- WELL COMPLETION DATA:
- (1) diameter (inches) 4"
  - (2) total depth (feet) 153
  - (3) static water level (feet) 121 below top of ground
  - (4) casing Plast Biltan  
(material) (depth)
  - (size) if telescope see back.
  - (5) screen 6" 115  
(length) (depth to top)
  - 4" Plast  
(size) (material)
  - (6) pump 1/2 Gal 10  
(HP) (yield gpm)
  - Electric  
(type power)
  - (7) electric log No  
(yes or no)
  - (organization running log)
  - (8) how well bottom plugged wooden plug


DRILLERS REMARKS:  
New location

RECEIVED  
OCT 21 1974

MISS. BD. OF WATER COMMISSIONERS

If well telescopes please sketch and show depths.

GROUND LEVEL

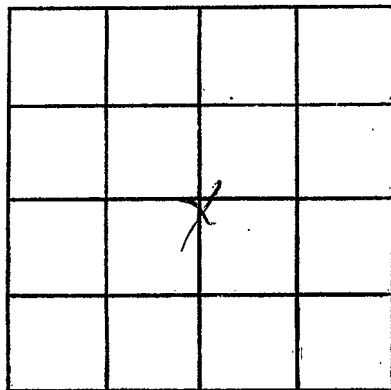

SECTION 4

Please indicate well location X.

ADDITIONAL INFORMATION

If more than one screen,  
show locations of each on sketch.