

LINCOLN
K 22
3-25-75

MISSISSIPPI
BOARD OF WATER COMMISSIONERS
416 North State Street
Jackson, Mississippi 39201

CO-22

WATER WELL DRILLERS LOG

3-25 19 25 Fitzgerald Well Service Lincoln
date well completed firm name county well located

LANDOWNER:	description of formations encountered	from	to
<u>Martin Jackson</u>			
<u>Dr. Brookhoven, Miss</u> (mailing address)	<u>Red clay</u>	<u>0</u>	<u>12</u>
	<u>white & blue clay</u>	<u>12</u>	<u>92</u>
	<u>lanel</u>	<u>92</u>	<u>100</u>

WELL LOCATION:
sec. 9 T 6 N R. 6 E
10 miles W of Brookhaven
(distance) (direction) (nearest town)

WELL PURPOSE: Home
(home, irrigation, municipal, industrial)

- WELL COMPLETION DATA:
- (1) diameter (inches) 4
 - (2) total depth (feet) 100
 - (3) static water level (feet) 80 below above top of ground.
 - (4) casing plastic, 92
(material) (depth)
4 if telescope see back.
(size)
 - (5) screen 8, 92
(length) (depth to top)
4, plastic
(size) (material)
 - (6) pump 1/2, 6
(HP) (yield gpm)
elec
(type power)
 - (7) electric log no
(yes or no)
(organization running log)
 - (8) how well bottom plugged land shell


RECEIVED

APR - 2 1975

DRILLERS REMARKS:

If well telescopes please sketch and show depths.

GROUND LEVEL

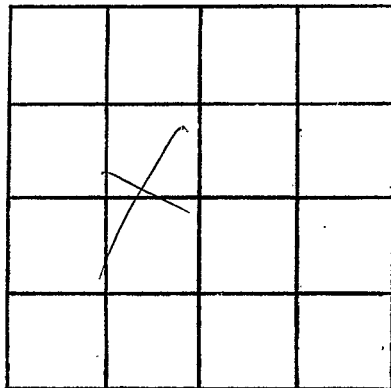

SECTION 9

Please indicate well location X.

ADDITIONAL INFORMATION

If more than one screen,
show locations of each on sketch.