

LINCOLN
K23
7-24-75

MISSISSIPPI
BOARD OF WATER COMMISSIONERS
416 North State Street
Jackson, Mississippi 39201

CODED

WATER WELL DRILLERS LOG

24 July 19
date well completed

J.T. Conroy & Son
firm name

Lincoln
county well located

LANDOWNER:
James Talbert
Brookhome
(mailing address)

description of formations encountered	from	to
Clay	0	25
Red clay	25	65
Sand	65	60
Clay	60	70
Sand	70	74

WELL LOCATION:
sec. 9 T. 6 N. R. 6 E
(distance) miles (direction) of (nearest town)

WELL PURPOSE:
(home, irrigation, municipal, industrial)

WELL COMPLETION DATA:

(1) diameter (inches) 4

(2) total depth (feet) 114

(3) static water level (feet) 60 below top of ground.

(4) casing P1, 103 (material) (depth)
(size) if telescope see back.


(5) screen 6, 103 (length) (depth to top)
4, P1 (size) (material)

(6) pump 1/2, 8 (HP) (yield gpm)
Electric (type power)

(7) electric log (yes or no)

(organization running log)

(8) how well bottom plugged used

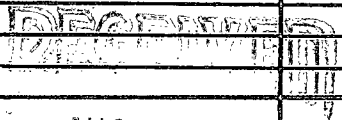

AUG 21 1975

DRILLERS REMARKS:

