

CODED


MISSISSIPPI  
BOARD OF WATER COMMISSIONERS  
416 North State Street  
Jackson, Mississippi 39201

WATER WELL DRILLERS LOG

Lincoln  
K 24  
7-10-75

July 10 1975 Grenn Water Well Contr. Lincoln  
date well completed firm name county well located

LANDOWNER: Decatur Rushing Rt. 5, Box 181 Brookhaven, Miss. (mailing address)	description of formations encountered Citronelle	from 0	to 85
<b>WELL LOCATION:</b>			
sec. <u>15</u> T <u>X</u> <u>6N</u> R <u>6E</u> <sup>144</sup> <u>6</u> miles SW of Brookhaven (distance) (direction) (nearest town)			
<b>WELL PURPOSE:</b> home (home, irrigation, municipal, industrial)			
<b>WELL COMPLETION DATA:</b>			
(1) diameter (inches) <u>6"</u>			
(2) total depth (feet) <u>85</u>			
(3) static water level (feet) <u>64</u> <u>below</u> <del>above</del> top of ground.			
(4) casing <u>PVC</u> <u>79'</u> (material) (depth) <u>4"</u> (size) if telescope see back.			
(5) screen <u>6'</u> <u>79'</u> (length) (depth to top) <u>.010</u> <u>PVC</u> (size) (material)			
(6) pump <u>did not install</u> (HP) (yield gpm)  (type power)			
(7) electric log <u>no</u> (yes or no)  (organization running log)			
(8) how well bottom plugged <u>wood</u>			
DRILLERS REMARKS:			

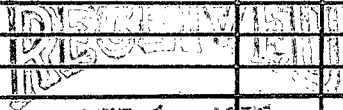

SEP 10 1975

If well telescopes please sketch and show depths.

GROUND LEVEL

			X

SECTION 15

Please indicate well location X.

ADDITIONAL INFORMATION

If more than one screen, show locations of each on sketch.