

Lincoln  
K 25  
10/3/80

MISSISSIPPI  
BOARD OF WATER COMMISSIONERS  
416 North State Street  
Jackson, Mississippi 39201

1 1/4 miles  
SW of  
Woolworth

CODED

WATER WELL DRILLERS LOG

*Syner Drilling Service, Inc*

*Lincoln*

10-3-80  
date well completed

firm name

county well located

LANDOWNER:

*Transco Exploration*  
*P.O. Box 1356*  
*Houston, Tx 77001*  
(mailing address)

description of formations encountered

from to

<i>sand &amp; clay</i>	<i>CODED 10</i>	<i>21</i>
<i>clay</i>	<i>21</i>	<i>189</i>
<i>clay and sand</i>	<i>189</i>	<i>315</i>
<i>sand, clay</i>	<i>315</i>	<i>381</i>

WELL LOCATION: *990' N & 230' W*

*N 01* sec. *11* T. *6* S. R. *60* of *W. 5* sec. *10* of *Brookhaven*  
(distance) (direction) (nearest town)

WELL PURPOSE: *oil field*  
(home, irrigation, municipal, industrial)

WELL COMPLETION DATA:

- (1) diameter (inches) *3"*
- (2) total depth (feet) *381'*
- (3) static water level (feet) *65'* <sup>below</sup> <sub>above</sub> top of ground.
- (4) casing *steel*, *381'*  
(material) (depth)
- 3"*  
(size) if telescope see back.
- (5) screen *42'*, *339'*  
(length) (depth to top)
- 3"*, *perforated*  
(size) (material)
- (6) pump *75*  
(HP) (yield gpm)
- ac*  
(type power)
- (7) electric log    
(yes or no)

(organization running log)

(8) how well bottom plugged *orange*  
*peel*

DRILLERS REMARKS:


DEPT. OF NATURAL RESOURCES  
BUREAU OF LAND & WATER RESOURCES

OCT 23 1980

RECEIVED

If well telescopes please sketch and show depths.

GROUND LEVEL

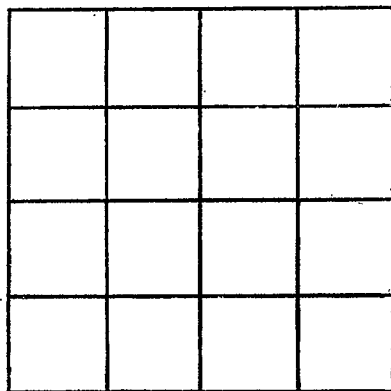

SECTION \_\_\_\_\_

Please indicate well location X.

ADDITIONAL INFORMATION

If more than one screen, show locations of each on sketch.