

MISSISSIPPI DEPARTMENT OF NATURAL RESOURCES

Bureau of Land and Water Resources

Southport Mall

P.O. Box 10631

Jackson, Mississippi 39209

WATER WELL DRILLERS LOG

CODED

LINCOLN
K26
3-12-81

Griner Drilling Service, Inc.

Lincoln

date well completed

firm name

county well located

LANDOWNER:

Exxon Company U.S.A.
P.O. Box 53226
New Orleans, La
(mailing address)

description of formations encountered

from

to

clay

0 21

sand

21 84

chalk

84 126

sand

126 189

chalk

CODED

189 294

sand

294 336

chalk

336 399

sand

399 525

chalk

525 567

WELL LOCATION: 46°1'N 4 382'E

No. 10 T 6 R 6 of
Reves Hurricane Lake Field
Black et al
(distance) (direction) (nearest town)

WELL PURPOSE: oil field supply
(home, irrigation, municipal, industrial)

WELL COMPLETION DATA:

#1 well

diameter (inches) 3"
(2) total depth (feet) 580'
(3) static water level (feet) 150' below top of ground.
(4) casing Steel 525'
(material) (depth)
3" If telescope see back.
(size)

(5) screen 42' 48.3'
(length) (depth to top)

3" perforated
(size) (material)

(6) pump 70
(HP) (yield gpm)

AC
(type power)

(7) electric log
(yes or no)

(organization running log)

(8) how well bottom plugged Orange
peel

DRILLERS REMARKS:


DEPT. OF NATURAL RESOURCES
BUREAU OF LAND & WATER RESOURCES

MAR 31 1981

RECEIVED

If well telescopes please sketch and show depths.

GROUND LEVEL

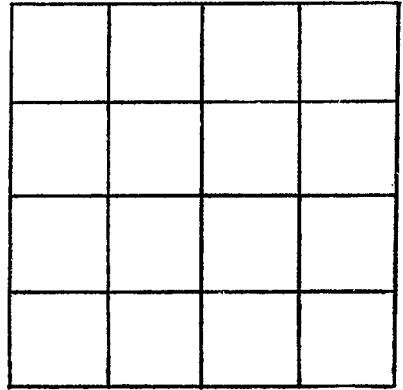

SECTION _____

Please indicate well location X.

ADDITIONAL INFORMATION

If more than one screen, show locations of each on sketch.