

MISSISSIPPI DEPARTMENT OF NATURAL RESOURCES

Bureau of Land and Water Resources

Southport Mall

P.O. Box 10631

Jackson, Mississippi 39209

WATER WELL DRILLERS LOG

Griner Drig. Co.

LINCOLN

Lincoln
K27
3-12-81

3-12-81

date well completed

firm name

county well located

LANDOWNER:	description of formations encountered	from	to
Exxon Co. USA (mailing address)			
WELL LOCATION: sec. <u>10</u> T <u>6</u> N R <u>6</u> E <u>461' N + 382' E</u> of SW <u>1/4</u> cr. (distance) (direction) (nearest town)	LOG CODED same		
WELL PURPOSE: (home, irrigation, municipal, industrial)	25		
#2 WELL COMPLETION DATA: Well	well		
(1) diameter (inches) <u>3"</u>	#1		
(2) total depth (feet) <u>525'</u>			
(3) static water level (feet) <u>150'</u> below above top of ground.			
(4) casing <u>steel</u> , <u>525'</u> (material) (depth)			
<u>3"</u> (size) If telescope see back.			
(5) screen <u>42'</u> , <u>483'</u> (length) (depth to top)			
<u>3"</u> , <u>perforated</u> (size) (material)			
(6) pump <u>70</u> (HP) (yield gpm)			
<u>AC</u> (type power)			
(7) electric log <u>—</u> (yes or no)			
<u>—</u> (organization running log)			
(8) how well bottom plugged <u>orange peel</u>			
DRILLERS REMARKS:			


DEPT. OF NATURAL RESOURCES
BUREAU OF LAND & WATER RESOURCES

MAR 31 1981

RECEIVED

If well telescopes please sketch and show depths.

GROUND LEVEL

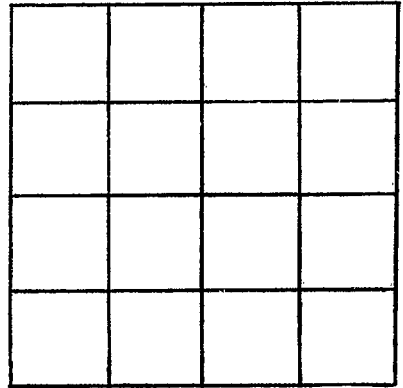

SECTION _____

Please indicate well location X.

ADDITIONAL INFORMATION

If more than one screen, show locations of each on sketch.