

Lincoln
K30
1/24/83

MISSISSIPPI DEPARTMENT OF NATURAL RESOURCES

Bureau of Land and Water Resources

Southport Mall

P.O. Box 10631

Jackson, Mississippi 39209

WATER WELL DRILLERS LOG

Griner Drilling Service, Inc.

Lincoln

1-24-83
date well completed

firm name

county well located

LANDOWNER:

Nicor Drilling
P.O. Box 430
Natchez, Ms. 39120
(mailing address)

description of formations encountered

from

to

sand

0

42

clay, sand

42

147

WELL LOCATION: 2310' S 4 993' W

sec. 10 T. 6N R. 6E NE/40

sand, pea gravel

147

189

clay, sand, clay

189

420

WELL PURPOSE: oil field supply
(home, irrigation, municipal, industrial)

sand, pea gravel

420

490

WELL COMPLETION DATA:

sand, clay

490

495

(1) diameter (inches)

3"

(2) total depth (feet)

495'

(3) static water level (feet)

80'

below above

(4) casing

steel

490'

(material)

(depth)

3"

(size)

if telescope see back.

(5) screen

42'

448'

(length)

(depth to top)

3"

(size)

perforated

(material)

(6) pump

—

(HP)

75-80

(yield gpm)

AC

(type power)

(7) electric log

(yes or no)

(organization running log)

(8) how well bottom plugged

orange

peel

DRILLERS REMARKS:

CODED


DEPT. OF NATURAL RESOURCES
BUREAU OF LAND & WATER RESOURCES

JAN 31 1983

RECEIVED

If well telescopes please sketch and show depths.

GROUND LEVEL

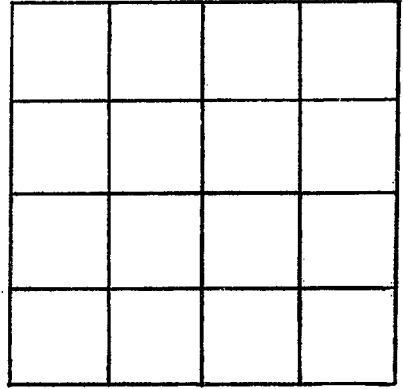

SECTION _____

Please indicate well location X.

ADDITIONAL INFORMATION

If more than one screen, show locations of each on sketch.