

COPED

LINCOLN
R 31
3-2-77

MISSISSIPPI
BOARD OF WATER COMMISSIONERS
416 North State Street
Jackson, Mississippi 39201

WATER WELL DRILLERS LOG

March 2, 1977 Grenn Water Well Cont. Lincoln
date well completed firm name county well located


LANDOWNER:	description of formations encountered	from	to
Joe Mozola	lay	1	18
Rt. 5, Box 219	Sand	18	50
Brookhaven, miss	Gravel	50	62
(mailing address)	white clay	62	80
WELL LOCATION:	blue clay	80	177
sec. 21 T 6 N R 6 E	white clay	177	185
11 miles SW of Brookhaven	sand	185	246
(distance) (direction) (nearest town)			
WELL PURPOSE: Home			
(home, irrigation, municipal, industrial)			
WELL COMPLETION DATA:			
(1) diameter (inches) 6"			
(2) total depth (feet) 246			
(3) static water level (feet) 150 below top of ground.			
(4) casing PVC 240 (material) (depth)			
4" (size) If telescope see back.			
(5) screen 6" 240" (length) (depth to top)			
.010 PVC (size) (material)			
(6) pump 1 Sub 10 (HP) (yield gpm)			
electricity (type power)			
(7) electric log no (yes or no)			
(organization running log)			
(8) how well bottom plugged Bask Wash Valve			
DRILLERS REMARKS:			

RECEIVED
APR 22 1977

MISSISSIPPI BOARD OF WATER COMMISSIONERS

If well telescopes please sketch and show depths.

GROUND LEVEL

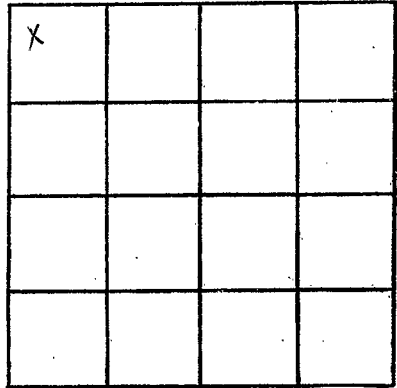

SECTION 21

Please indicate well location X.

ADDITIONAL INFORMATION

If more than one screen,
show locations of each on sketch.