

MISSISSIPPI DEPARTMENT OF NATURAL RESOURCES

Bureau of Land and Water Resources

Southport Mall

P.O. Box 10631

Jackson, Mississippi 39209

WATER WELL DRILLERS LOG

CODED

Griner Drilling Service, Inc.

Lincoln

LINCOLN
K 33
6/3/83

6-3-83 date well completed

Griner Drilling Service, Inc. firm name

Lincoln county well located

LANDOWNER:	description of formations encountered	from	to
Marion Drilling P.O. Box 3027 Daphne, Ala. 36526 (mailing address)	clay, 5' of sand SAND	0 406	406 439 441
WELL LOCATION: 400.5 4660'E sec. 27 T. 60 N. R. 6E NW/4 No. 15 L. Bogue Chitto 0.75 miles (direction) (nearest town)	CODED		
WELL PURPOSE: oilfield supply (home, irrigation, municipal, industrial)			
WELL COMPLETION DATA:			
(1) diameter (inches) 3"			
(2) total depth (feet) 441'			
(3) static water level (feet) 100' below top of ground.			
(4) casing steel 441' (material) (depth) 3" (size) if telescope see back.			
(5) screen 42' 399' (length) (depth to top) 3" perforated (size) (material)			
(6) pump AC (HP) 60 (yield gpm) (type power)			
(7) electric log (yes or no) (organization running log)			
(8) how well bottom plugged orange peel			
DRILLERS REMARKS:			


DEPT. OF NATURAL RESOURCES
BUREAU OF LAND & WATER RESOURCES

JUN 22 1983

RECEIVED

If well telescopes please sketch and show depths.

GROUND LEVEL

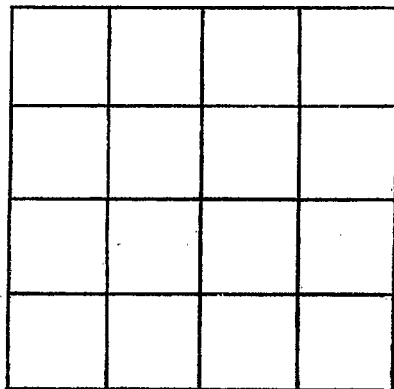

SECTION _____

Please indicate well location X.

ADDITIONAL INFORMATION

If more than one screen, show locations of each on sketch.