

MISSISSIPPI DEPARTMENT OF NATURAL RESOURCES

Bureau of Land and Water Resources

Southport Mall

P.O. Box 10631

Jackson, Mississippi 39209

WATER WELL DRILLERS LOG **CODED**

Griner Drilling Service, Inc.

Lincoln

K34
Lincoln Co.
10-8-83

10-8-83
date well completed

Griner Drilling Service, Inc.
firm name

Lincoln
county well located


LANDOWNER:	description of formations encountered	from	to
Justiss Oil P.O. Box N Jena, La. 71342 (mailing address)	chalk	0	21
WELL LOCATION: 190' N + 330' W sec. 25 T 6 N R 6 E SE 1/4 No. 1 Jackson Bogue Chitto Reservoir (distance) miles (direction) of (nearest town)	sand, gravel	21	74
WELL PURPOSE: oil field supply (home, irrigation, municipal, industrial)	rock, chalk	74	102
WELL COMPLETION DATA:	sand	102	168
(1) diameter (inches) <u>3"</u>	SEV4, SEV4		
(2) total depth (feet) <u>200'</u>			
(3) static water level (feet) <u>50' below</u> top of ground.			
(4) casing <u>steel, 168'</u> (material) (depth) <u>3"</u> (size) if telescope see back.			
(5) screen <u>42', 126'</u> (length) (depth to top) <u>3" perforated</u> (size) (material)			
(6) pump <u>—</u> <u>70</u> (HP) (yield gpm) <u>AC</u> (type power)			
(7) electric log <u>—</u> (yes or no) <u>—</u> (organization running log)			
(8) how well bottom plugged <u>orange peel</u>			
DRILLERS REMARKS:			

DEPT. OF NATURAL RESOURCES
BUREAU OF LAND & WATER RESOURCES

NOV 29 1983
RECEIVED

If well telescopes please sketch and show depths.

GROUND LEVEL

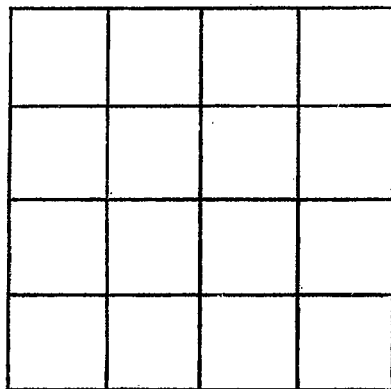

SECTION _____

Please indicate well location X.

ADDITIONAL INFORMATION

If more than one screen,
show locations of each on sketch.