

MISSISSIPPI DEPARTMENT OF NATURAL RESOURCES

Bureau of Land and Water Resources

Southport Mall

P.O. Box 10631

Jackson, Mississippi 39209

WATER WELL DRILLERS LOG

CODED

L36
Lincoln Co.
12-12-84

12-12-84 date well completed
Griner Drilling Service, Inc. firm name
Lincoln county well located


LANDOWNER:	description of formations encountered	from	to
See Land Drilling 900 Dunn Street Houma, La. 70360 (mailing address)			
WELL LOCATION: 1065'S + 1684'E sec. 16 T 6 N R 6 E of No. 1 Bd. W. Lincoln of Ed. miles (distance) (direction) (nearest town)	clay	30	110
	sand, gravel	110	210
	clay, sand	210	380
WELL PURPOSE: oil field supply (home, irrigation, municipal, industrial)	COURSE SAND	380	441
WELL COMPLETION DATA:			
(1) diameter (inches) 3"			
(2) total depth (feet) 441'			
(3) static water level (feet) 65' below top of ground.			
(4) casing steel 441' (material), (depth)			
3" (size) if telescope see back.			
(5) screen 42' 399' (length), (depth to top)			
3" (size), perforated (material)			
(6) pump - 80-90 (HP), (yield gpm)			
AC (type power)			
(7) electric log (yes or no)			
(organization running log)			
(8) how well bottom plugged orange peel			
DRILLERS REMARKS:			

RECEIVED
FEB 11 1985

Department of Natural Resources
Bureau of Land & Water Resources

If well telescopes please sketch and show depths.

GROUND LEVEL

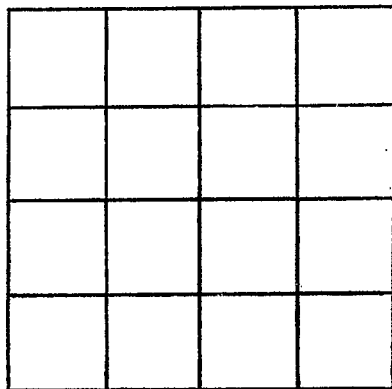

SECTION _____

Please indicate well location X.

ADDITIONAL INFORMATION

If more than one screen, show locations of each on sketch.