

MISSISSIPPI DEPARTMENT OF NATURAL RESOURCES

Bureau of Land and Water Resources

Southport Mall

P.O. Box 10631

CODED

Jackson, Mississippi 39209

WATER WELL DRILLERS LOG

K37
LINCOLN
4-10-85

4-10-85 Griner Drilling Service, Inc.

Lincoln

date well completed

firm name

county well located

LANDOWNER:

See Land Drilling
900 Dunn Street
Houma, La. 70360
(mailing address)

description of formations encountered

from

to

SAND

0 53

CLAY CODED

53 130

SAND & GRAVEL

130 215

streaked clay
& SAND

215 400

SAND

400 483

WELL LOCATION: 990'N & 995'E

sec. 17 T. 6 N R. 6 E of SW/4

NO. 1 West Lincoln
17-13
(distance) miles (direction) of (nearest town)

WELL PURPOSE: oilfield rig supply
(home, irrigation, power, industrial)

WELL COMPLETION DATA:

- (1) diameter (inches) 3"
- (2) total depth (feet) 483'
- (3) static water level (feet) 80' below top of ground.
- (4) casing steel 483' (material) (depth)
3" (size) if telescope see back.
- (5) screen 42' 441' (length) (depth to top)
3" perforated (size) (material)
- (6) pump - 75 (HP) (yield gpm)
AC (type power)
- (7) electric log (yes or no) no

(organization running log)

- (8) how well bottom plugged Orange
peel


DRILLERS REMARKS:

RECEIVED
APR 7 8 1985

Department of Natural Resources
Bureau of Land & Water Resources

If well telescopes please
sketch and show depths.

GROUND LEVEL

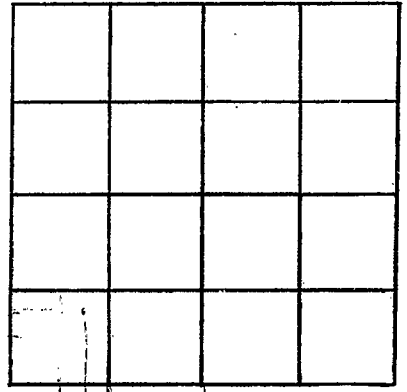

SECTION _____

Please indicate well location X.

ADDITIONAL INFORMATION

If more than one screen,
show locations of each on sketch.