

LINCOLN

K39

MISSISSIPPI DEPARTMENT OF NATURAL RESOURCES

Bureau of Land and Water Resources

Southport Mall

P.O. Box 10631

Jackson, Mississippi 39209

WATER WELL DRILLERS LOG

CODED

11-8

1984

Green Water Well

Lincoln

date well completed

firm name

county well located

LANDOWNER: John Ragsdale

description of formations encountered

from to

Rt. 5, Box 776 B

Clay

1 20

Brookhaven, Ms.
(mailing address)

sand & gravel

20 35

white clay

35 120

sand

120 150

WELL LOCATION:

sec 4-T 6-N R 6-E
S W

CODED

8 miles SW of Brookhaven
(distance) (direction) (nearest town)

WELL PURPOSE: home
(home, irrigation, municipal, industrial)

WELL COMPLETION DATA:

- (1) diameter (inches) 4
- (2) total depth (feet) 150
- (3) static water level (feet) 95 below above top of ground.
- (4) casing PVC 140
(material) (depth)
.010 If telescope see back.
(size)
- (5) screen 10' 140'
(length) (depth to top)
.010 PVC
(size) (material)
- (6) pump 3/4 sub 10
(HP) (yield gpm)
electricity
(type power)
- (7) electric log no
(yes or no)

(organization running log)

(8) how well bottom plugged -
back wash valve


DRILLERS REMARKS:

RECEIVED
APR 17 1985

Department of Natural Resources
Bureau of Land & Water

If well telescopes please
sketch and show depths.

GROUND LEVEL

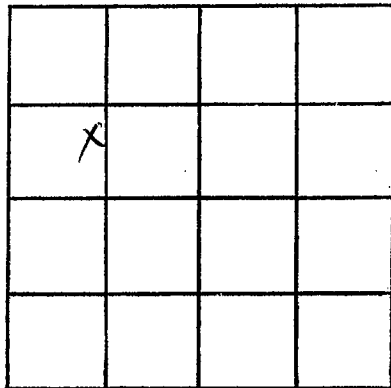

SECTION 4

Please indicate well location X.

ADDITIONAL INFORMATION

If more than one screen,
show locations of each on sketch.