

MISSISSIPPI DEPARTMENT OF NATURAL RESOURCES
 Bureau of Land and Water Resources
 Southport Mall
 P.O. Box 10631
 Jackson, Mississippi 39209
WATER WELL DRILLERS LOG

CODED

Lincoln
R 40
5/16/85

5-16-85 Griner Drilling Service, Inc. Lincoln

date well completed firm name county well located

LANDOWNER:	description of formations encountered	from	to
<u>See Land Drilling</u> <u>900 Dunn Street</u> <u>Houma, La. 70360</u> (mailing address)	<u>streaked, clay</u>	<u>0</u>	<u>147</u>
	<u>sand, p. gravel</u>	<u>147</u>	<u>252</u>
WELL LOCATION: <u>630'N x 1800'W</u> sec. <u>15</u> T. <u>60</u> N R. <u>60</u> E of <u>SE/40</u>	<u>clay, streaked</u>	<u>252</u>	<u>462</u>
No. <u>1</u> Unit <u>15</u> <u>15</u> miles (distance) <u>W</u> (direction) <u>Lincoln Field</u> (nearest town)	<u>sand</u>	<u>462</u>	<u>525</u>
WELL PURPOSE: <u>oilfield supply</u> (home, irrigation, municipal, industrial)	<u>clay</u>	<u>525</u>	<u>546</u>

WELL COMPLETION DATA:

- (1) diameter (inches) 3"
- (2) total depth (feet) 546'
- (3) static water level (feet) 150' below above top of ground.
- (4) casing steel, 525'
(material) (depth)
3"
(size) If telescope see back.
- (5) screen 42', 483'
(length) (depth to top)
3", perforated
(size) (material)
- (6) pump —, 80
(HP) (yield gpm)
AC
(type power)
- (7) electric log (yes or no)

(organization running log)

- (8) how well bottom plugged orange
peel

DRILLERS REMARKS:


RECEIVED

JUN 4 1985

Department of Natural Resources
 Bureau of Land & Water Resources

If well telescopes please
sketch and show depths.

GROUND LEVEL

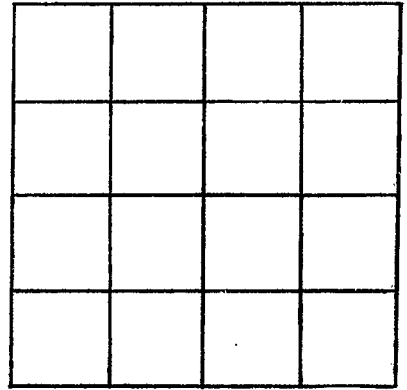

SECTION _____

Please indicate well location X.

ADDITIONAL INFORMATION

If more than one screen,
show locations of each on sketch.