

MISSISSIPPI DEPARTMENT OF NATURAL RESOURCES

Bureau of Land and Water Resources

Southport Mall

P.O. Box 10631

Jackson, Mississippi 39209

WATER WELL DRILLERS LOG

CODED

LINCOLN
K 42

Griner Drilling Service, Inc.

LINCOLN


7-2-86 date well completed

firm name

county well located

LANDOWNER:	description of formations encountered	from	to
Santa Fe Energy Co. One Security Park, 7200 I-40 West Amarillo, TX 79106	SAND, pea gravel	0	80
WELL LOCATION: 330°S + 1707°E sec. 14 T. 6N R. 6E of No. 1 Patchiff W. LINCOLN (distance) (direction) (nearest town)	clay	80	140
WELL PURPOSE: oilfield rig (home, irrigation, municipal, industrial)	SAND, gravel	140	245
WELL COMPLETION DATA:	clay	245	257
(1) diameter (inches) 4"			
(2) total depth (feet) 257'			
(3) static water level (feet) 70' below top of ground.			
(4) casing steel, 235' (material) (depth) 4" (size) if telescope see back.			
(5) screen 20' (length), 215' (depth to top) 4" (size), STAINLESS (material)			
(6) pump 5 HP, 90 (yield gpm) 230 VOLT 3 phase (type power)			
(7) electric log (yes or no)			
(organization running log)			
(8) how well bottom plugged 4" back WASH VALVE			
DRILLERS REMARKS:			

CODED

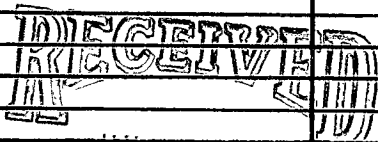


JUL 10 1986

Department of Natural Resources
Bureau of Land and Water Resources

If well telescopes please sketch and show depths.

GROUND LEVEL

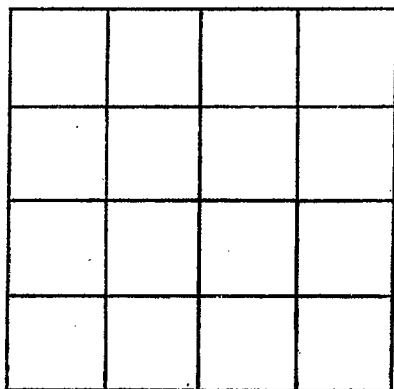

SECTION _____

Please indicate well location X.

ADDITIONAL INFORMATION

If more than one screen,
show locations of each on sketch.