

MISSISSIPPI DEPARTMENT OF NATURAL RESOURCES

Bureau of Land and Water Resources

Southport Mall

P.O. Box 10631

Jackson, Mississippi 39209

WATER WELL DRILLERS LOG

LINCOLN  
K 43

CODED

6-24

19

86

Green Water Well

Lincoln


date well completed

firm name

county well located

LANDOWNER:	description of formations encountered	from	to
Gum Grove Baptis Church Rt. 5, Box 626	Clay	1	10
Brookhaven	sand & gravel	10	20
(mailing address)	white clay	20	40
	blue clay	40	170
WELL LOCATION:	white clay	120	185
sec. 24 T 6 N R 6 E S W	sand	185	210
9 miles SW of Brookhaven (distance) (direction) (nearest town)			
WELL PURPOSE: church (home, irrigation, municipal, industrial)			
WELL COMPLETION DATA:			
(1) diameter (inches) 4			
(2) total depth (feet) 210			
(3) static water level (feet) 65 below above top of ground.			
(4) casing PVC 200 (material) (depth) 4" If telescope see back. (size)			
(5) screen 10' 200' (length) (depth to top) .010 PVC (size) (material)			
(6) pump 1/2 sub 10 (HP) (yield gpm) electricity (type power)			
(7) electric log no (yes or no) (organization running log)			
(8) how well bottom plugged back wash valve			
DRILLERS REMARKS:			


CODED

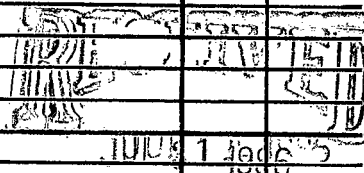

Department of Natural Resources  
Bureau of Land and Water Resources

If well telescopes please sketch and show depths.

GROUND LEVEL

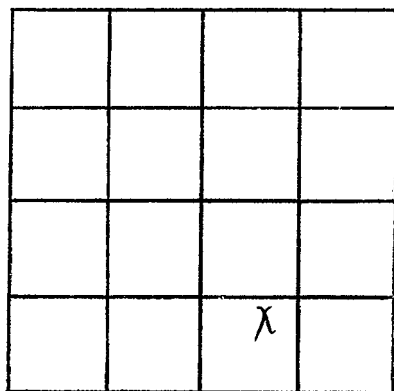

SECTION 24

Please indicate well location X.

ADDITIONAL INFORMATION

If more than one screen,  
show locations of each on sketch.