

MISSISSIPPI DEPARTMENT OF NATURAL RESOURCES

Bureau of Land and Water Resources

Southport Mall

P.O. Box 10631

Jackson, Mississippi 39209

WATER WELL DRILLERS LOG

CODED

LINCOLN
K 45

9-26-88

Griner Drilling Service, Inc.

Lincoln

date well completed

firm name

county well located

LANDOWNER:
Henley Drilling Co.
P.O. 1401 Elm Street
Suite 3600
Dallas, TX 75202

description of formations encountered

from

to

clay

0 116

sand

116 195

WELL LOCATION:

sec. 29 T 60 N R 6 E
Hunt Oil McCalls Creek
(distance) miles (direction) of (nearest town)

WELL PURPOSE: oilfield rig
(home, irrigation, municipal, industrial)
supply

WELL COMPLETION DATA:

(1) diameter (inches) 4"
(2) total depth (feet) 195'

(3) static water level (feet) 118' (below top of ground)

(4) casing PVC 195'
(material) (depth)

4" (size) if telescope see back.

(5) screen 40' 165'
(length) (depth to top)

4" PVC SCREEN (size) (material)

(6) pump 5 HP 50
(HP) (yield gpm)

230 volt 3 phase (type power)

(7) electric log (yes or no)

4" backwash (organization / running log)
NAIVE

(8) how well bottom plugged

1 C. LOFTON 29-10
330' S & 455' E OF NW COR

RECEIVED


NOV 14 1988

Department of Natural Resources
Bureau of Land & Water Resources

DRILLERS REMARKS:

If well telescopes please sketch and show depths.

GROUND LEVEL

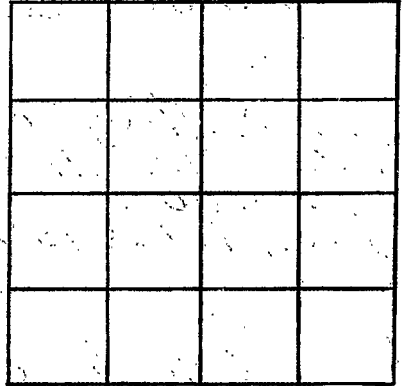

SECTION _____

Please indicate well location X.

ADDITIONAL INFORMATION

If more than one screen, show locations of each on sketch.