

MISSISSIPPI DEPARTMENT OF NATURAL RESOURCES
 Bureau of Land and Water Resources
 Southport Mall
 P.O. Box 10631
 Jackson, Mississippi 39209
WATER WELL DRILLERS LOG

LINCOLN
~~132~~
4-16-85

K46

April 16, 1985 Grenn Water Wel:1 I, Lincoln
 date well completed firm name county well located

LANDOWNER:

Lincoln County Schools for
 West Lincoln School
 P.O. Box 826
 Brookhaven, Ms.
 (mailing address)

description of formations encountered

from to

Clay	1	20
sand & gravel	20	60
white clay	60	85
fine sand	85	95
white clay	95	110
blue clay	110	140
white clay	140	160
sand	160	223


WELL LOCATION:

23 sec 14-T-6 (N) R-6 (E)
 (see map) S W
 10 miles SW of Brookhaven
 (distance) (direction) (nearest town)

WELL PURPOSE: school
 (home, irrigation, municipal, industrial)

WELL COMPLETION DATA:

- (1) diameter (inches) 4
- (2) total depth (feet) 223
- (3) static water level (feet) 100 below above top of ground.
- (4) casing PVC, 203' (material), (depth),
 4" if telescope see back. (size)
- (5) screen 20' (length), 203± (depth to top)
 .010 PVC (size), (material)
- (6) pump 1½ sub 18 (HP), (yield gpm)
 electricity (type power)
- (7) electric log no (yes or no)
 (organization running log)
- (8) back wash valve
- how well bottom plugged

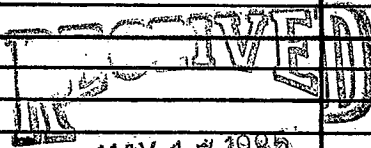

MAY 17 1985

Department of Natural Resources
 Bureau of Land & Water Resources

DRILLERS REMARKS:

If well telescopes please sketch and show depths.

GROUND LEVEL

			X

SECTION 14

Please indicate well location X.

ADDITIONAL INFORMATION

If more than one screen,
show locations of each on sketch.