
	Well Report	
	- Driller's Log	For Office Use Only:
Mississippi Depart	ment of Environmental Quality	Aquifer:
	id and Water Resources .O. Box 2309	Well #:
Driller: KITZGERA IC Well feron Jack	(son, MS 39225	L. S. Elevation:
	01)961-5210	L. S. Elevation:
(601)961- 5228 (fax)	E-log #:
State Law requires that this report be prepared by the	e license holder responsible for t	the work and filed with the
Department at the above address within 30 days of c	ompletion of drilling of the well	or borehole.
Information on Well Owner (Landowner if borehole is not for a water well)		orehole Location
	Latitude: 31 . 28 , 4/4	Longitude: 90°36, 44,4
Owner Name Jason Wullare		
Mailing Address: Tiger Tr	Method of Lat/Long (circle or	ie): Conventional Survey,
		GPS, Survey-grade GPS
	NW WNW 1/ can 21	Twn QN Rng GE
Bose ch to MS. City State Zip Code	/4 <u>1 - v</u> /4 SCU <u>V V</u>	
City State Zip Code		Nearest Town
Telephone No. ()	Miles	of
	Sorehole Data	_
Date drilling started: 6-73-10 Date drilling completed: 6-6	B-11 Hole depth: 215 -	Hole diameter: 8-11
Location of the source of any surface water used for drilling: Method of dosing and volume of Chlorine used in drilling and d	evelopment:	
Logs run (circle all applicable): No log run Electric Gamma	Pay Density Sonic Neutron	Other
	ay Density Some relation	
Purpose of borehole (check one): Water Well Geotechnical/	Geological Investigation Ground	Source Heat Pump
Seismic Survey Other (desc	ribe)	
If drilling is not related to water well constru	ction, skip the remainder of this blo	ock
Purpose of Well (check one): Home <u>Industrial</u> Public Su	pply Irrigation Fish Culture _	Other:
If a flowing well, method of flow regulation: Valve	_ Other (describe)	
Static Water Level:		6-23-10,
Method of Measurement (circle one) steel tape electric t	-	······
Well depth: $\frac{215}{}$ Well grouted to a depth of $\frac{10^{11}}{10^{11}}$ feet		0
Casing length:	inches Type of casing:	
Screen length: <u>20</u> feet Screen diameter: <u>4</u>	inches Type of screen:	
Screen slot size:inches Setting depth: From	mfeet to1	feet
Type of completion (circle all applicable): Oravel packet Un	derreamed Telescoped Open	hole Natural Development
Other (describe):	·····	
Top of lap pipe or reduction in casing:feet. 1	f telescoped or more than one scree	en, describe on next page
		Form: OLWR-SWR-1A (04/08)

3... y 66... 3

> AECEVED JUL 0 7 2010 BY: OLWAR

The sketch below only required for water wells Description of formations encountered must be provided for all wells and boreholes, unless specifically exempted by regulations If well telescopes, show depths on sketch. Description of Formations Encountered From (depth) To (depth) Ground Level. Z Ground Level 40 τı τ U 80 C 90 50 40 UNTO CUN

If more than one screen, show location of each on sketch

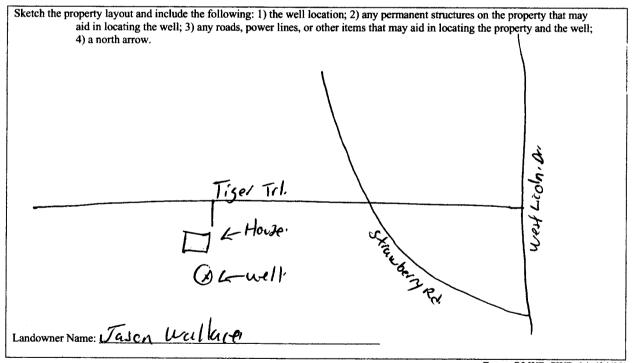

Form: OLWR-SWR-1A (04/08)

I certify that the well/borehole was drilled, constructed, and completed in accordance with all applicable requirements of the Mississippi Department of Environmental Quality and the Mississippi Department of Health regulations, if applicable, and state

Date

laws 1-12, pull Blud

Print Name of Responsible Licensee and License No.

673-10.

Signature of Licensee

HE(JEI)ED JUL 0 7 20.1

BY: OMIR

S1	FATE WELL REPORT	For Office Use Only:
County: Licoln	Part 2	
	ump Installer's Completion Report sippi Department of Environmental Quality	Aquifer:
1 1	Office of Land and Water Resources	Well #:
	P.O. Box 2309	
Date completed:	Jackson, MS 39225 (601)961-5210	Elevation:
Copy information from block on Part 1	(601)961-5228 (fax)	
This part of the report must be completed by a licen report must be attached and both parts filed with th	used water well contractor or a licensed pump	installer. A copy of Part 1 of the
report must be attached and both parts fued with th Well Owner Information		ell Location
Dwner Name: Jajon Weillar		Longitude: <u>40°36 44.4</u> "
Mailing Address: Tize: Trl.	Method of Lat/Long (check of	one): Conventional Survey,
		d GPS, Survey-grade GPS
Reyechtums City State Zij	¼¼ Sec_	TR
City State Zij	Distance Direction	Nearest Town
Felephone No. ()	Miles	of
Pump Type		ower Type
Circle one Air Lift Jet Submers		Circle one ine Engine Natural Gas
Bucket Piston Turbine	Electric Moto Hand	Tractor PTO
Centrifugal Rotary Flowing		(specify):
Other (specify):	Horse Power Rating of Moto	or: <u>3/4</u> .
Date Pump Installed: 6-13-10	Setting Depth:	feet
Rated Pump Capacity:Gallons F	Per Minute Number of Stages: 12	
Pump Test Data		easuring Water Level
Date Well Tested:	Air Line Electric Me	Circle one easuring Line Steel Tape
Static Water Level (A):Feet Below La	nd Surface	j (j
Pumping Water Level (B):Feet Below Lar	Other (specify):	
Drawdown [(B) – (A)]:Feet Below La		shut in head:feet
Fest Pumping Rate:Gallons P	Per Minute Well yielded	GPM with a drawdown of
Duration of Pump Test (minimum 4 hours):	hoursfeet after	hours of pumping
This is for (circle one): New Well Repl	acement of Existing Pump Repair of E	Existing Pump
HEREBY CERTIFY that the above statements are tr	rue to the best of my knowledge	
	KA STAL	
<u>R</u> , <u>n</u> <u>H</u> <u>C</u>	licable) Signature of Pump In	

× • • •