
		Well Report	For Office Use On
County: Licoh.		• Driller's Log ent of Environmental Quality	
Permit #:	Office of Land	and Water Resources	Aquifer:
Permit #: Driller: Felzgerald Well Same	P.C	D. Box 2309	Well #: K13
Driller. (Cheffrato wer save	Jacks (60	on, MS 39225 1)961- 5210	L. S. Elevation:
Date drilling completed: <u>4-6-6</u> ,		961- 5228 (fax)	E-log #:
State Law requires that this repo] rt he prepared by the l	icense holder responsible for i	
Department at the above address	s within 30 days of cor	npletion of drilling of the well	or borehole.
Information on Well		Well or Bo	rehole Location
(Landowner if borehole is not for a water well) Owner Name Andrew Redd		Latitude: 31°, 28', 18	" Longitude: 90 . 35
Mailing Address: west hicoly.		Method of Lat/Long (circle or	e): Conventional Survey,
maning multiss. • • • • • • • • • •	/	USGS quad, Hand-held	GPS, Survey-grade GPS
		NE K SEV Son 71	-Tum SA/ Dan 1
Borochto ms.	tte Zip Code	NE 1/4 SE 1/4 Sec 22	
City Sta	te Zip Code	Distance Direction	Nearest Town
Telephone No. ()		Miles	of
Location of the source of any surface wate Method of dosing and volume of Chlorin Logs run (circle all applicable). No log ru	er used for drilling: e used in drilling and dev De Electric Gamma Ra	velopment:	Other:
Date drilling started: 1-0-1 Date dr Location of the source of any surface wate Method of dosing and volume of Chlorin Logs run (circle all applicable). No log ru Name of organization running log(s): Purpose of borehole (check one): Water W	er used for drilling: e used in drilling and dev De Electric Gamma Ra	velopment: ay Density Sonic Neutron	Other:
Location of the source of any surface wate Method of dosing and volume of Chlorin Logs run (circle all applicable). No log ru Name of organization running log(s): Purpose of borehole (check one): Water W Seismic	er used for drilling: e used in drilling and dev Electric Gamma Ra /ell <u>C</u> Geotechnical/Ge Survey Other (<i>descri</i> .	velopment: ay Density Sonic Neutron ological Investigation Ground be)	Other: Source Heat Pump
Location of the source of any surface wate Method of dosing and volume of Chlorin Logs run (circle all applicable). No log ru Name of organization running log(s): Purpose of borehole (check one): Water W Seismic If drilling is not related	er used for drilling: e used in drilling and dev Electric Gamma Ra Vell <u>C</u> Geotechnical/Ge Survey Other (<i>descri</i> . <u>I to water well construct</u>	velopment: ay Density Sonic Neutron ological Investigation Ground be) ion, skip the remainder of this blo	Other: Source Heat Pump
Location of the source of any surface wate Method of dosing and volume of Chlorin Logs run (circle all applicable). No log ru Name of organization running log(s): Purpose of borehole (check one): Water W Seismic	er used for drilling: e used in drilling and dev Electric Gamma Ra Vell <u>C</u> Geotechnical/Ge Survey Other (<i>descri</i> . <u>I to water well construct</u>	velopment: ay Density Sonic Neutron ological Investigation Ground be) ion, skip the remainder of this blo	Other: Source Heat Pump
Location of the source of any surface wate Method of dosing and volume of Chlorin Logs run (circle all applicable). No log ru Name of organization running log(s): Purpose of borehole (check one): Water W Seismic If drilling is not related	er used for drilling: e used in drilling and dev Electric Gamma Ra /ell Geotechnical/Ge Survey Other (<i>descrit</i> <i>ito water well construct</i> ndustrial Public Supp	velopment: ay Density Sonic Neutron ological Investigation Ground be) ion, skip the remainder of this black oly Irrigation Fish Culture _	Other: Source Heat Pump
Location of the source of any surface wate Method of dosing and volume of Chlorin Logs run (circle all applicable). No log ru Name of organization running log(s): Purpose of borehole (check one): Water W Seismic If drilling is not related Purpose of Well (check one): Home	er used for drilling: e used in drilling and dev p Electric Gamma Ra /ell Geotechnical/Ge Survey Other (<i>descri</i> . <i>Ito water well construct</i> ndustrial Public Supp on: Valve	velopment: ay Density Sonic Neutron ological Investigation Ground be) ion, skip the remainder of this blo oly Irrigation Fish Culture Other (describe)	Other:
Location of the source of any surface wate Method of dosing and volume of Chlorin Logs run (circle all applicable). No log ru Name of organization running log(s): Purpose of borehole (check one): Water W Seismic If drilling is not related Purpose of Well (check one): Home If a flowing well, method of flow regulation	er used for drilling: e used in drilling and dev p Electric Gamma Ra /ell Geotechnical/Ge Survey Other (<i>descri</i> . / <i>to water well construct</i> ndustrial Public Supp on: Valve pove or below (circle one	velopment: ay Density Sonic Neutron ological Investigation Ground be) ion, skip the remainder of this block oly Irrigation Fish Culture Other (describe)) land surface Date measured:	Other:
Location of the source of any surface wate Method of dosing and volume of Chlorin Logs run (circle all applicable). No log ru Name of organization running log(s): Purpose of borehole (check one): Water W Seismic I If drilling is not related Purpose of Well (check one): Home1 If a flowing well, method of flow regulation Static Water Level:feet at Method of Measurement (circle one)	er used for drilling: e used in drilling and dev Delectric Gamma Ra /ell Geotechnical/Ge Survey Other (<i>descrit</i> <i>to water well construct</i> ndustrial Public Suppon: Valve powe or below (circle one reel tape electric tap	velopment: ay Density Sonic Neutron ological Investigation Ground be) ion, skip the remainder of this ble oly Irrigation Fish Culture Other (describe)) land surface Date measured: be air line other:	Other:
Location of the source of any surface wate Method of dosing and volume of Chlorin Logs run (circle all applicable). No log ru Name of organization running log(s): Purpose of borehole (check one): Water W Seismic If drilling is not related Purpose of Well (check one): Home1 If a flowing well, method of flow regulation Static Water Level:feet at Method of Measurement (circle one)st Well depth: Well grouted to a dep	er used for drilling: e used in drilling and dev D Electric Gamma Ra /ell Geotechnical/Ge Survey Other (<i>descri</i> . <i>ito water well construct</i> ndustrial Public Supp on: Valve powe or below (circle one teel tape electric tap epth of <u>10</u> feet Typ	velopment: ay Density Sonic Neutron ological Investigation Ground be) ion, skip the remainder of this black bly Irrigation Fish Culture Other (describe) Other (describe)) land surface Date measured: pe of grout (circle one): Near Cem	Other:
Location of the source of any surface wate Method of dosing and volume of Chlorin Logs run (circle all applicable) No log ru Name of organization running log(s): Purpose of borehole (check one): Water W Seismic If drilling is not related Purpose of Well (check one): HomeI If a flowing well, method of flow regulation Static Water Level:feet at Method of Measurement (circle one)f Well depth: Well grouted to a de Casing length:feet Casin	er used for drilling: e used in drilling and dev D Electric Gamma Ra /ell Geotechnical/Ge Survey Other (<i>descri</i> . <i>ho water well construct</i> ndustrial Public Supp on: Valve powe or below (circle one weel tape) electric tap epth of <u>10</u> feet Typ ng diameter: <u>9</u> ''	velopment: ay Density Sonic Neutron ological Investigation Ground be) ion, skip the remainder of this block oly Irrigation Fish Culture Other (describe)) land surface Date measured: pe of grout (circle one): Neat Cem inches Type of casing:	Other:
Location of the source of any surface wate Method of dosing and volume of Chlorin Logs run (circle all applicable). No log ru Name of organization running log(s): Purpose of borehole (check one): Water W Seismic If drilling is not related Purpose of Well (check one): Home1 If a flowing well, method of flow regulation Static Water Level:feet at Method of Measurement (circle one)st Well depth: Well grouted to a dep	er used for drilling: e used in drilling and dev Electric Gamma Ra /ell Geotechnical/Ge Survey Other (<i>descri</i> . / <i>to water well construct</i> ndustrial Public Supp on: Valve powe or below (circle one teel tape) electric tap epth of <u>/0</u> feet Typ ng diameter: <u>Y''</u> en diameter: <u>Y''</u>	velopment: ay Density Sonic Neutron ological Investigation Ground be) ion, skip the remainder of this block oly Irrigation Fish Culture Other (describe)) land surface Date measured: pe of grout (circle one): Neat Cem inches Type of screen: inches Type of screen:	Other:
Location of the source of any surface wate Method of dosing and volume of Chlorin Logs run (circle all applicable) No log ru Name of organization running log(s): Purpose of borehole (check one): Water W Seismic I If drilling is not related Purpose of Well (check one): HomeI If a flowing well, method of flow regulation Static Water Level:feet all Method of Measurement (circle one)f Well depth: Well grouted to a de Casing length:feet Casin Screen length: feet Screen Method of Measurement (circle one) feet Screen Screen length: feet Screen Screen length: for feet Screen Method of Measurement (circle one) feet Screen Screen length: feet Screen Method of Measurement (circle one) feet Screen Screen length: feet Screen Method of Measurement (circle one) feet Screen Screen length: feet Screen Method Screen length: Screen Method Screen length: Screen Method Screen length: Screen Method Screen length Screen Method Screen length S	er used for drilling: e used in drilling and dev D Electric Gamma Ra Vell C Geotechnical/Ge Survey Other (<i>descri</i> . <i>Ito water well construct</i> ndustrial Public Supp on: Valve pove or below (circle one teel tape) electric tap epth of <u>10</u> feet Typ ng diameter: <u>Y''</u> en diameter: <u>Y''</u> Setting depth: From	velopment: ay Density Sonic Neutron ological Investigation Ground be) ion, skip the remainder of this block oly Irrigation Fish Culture _ Other (describe)) land surface Date measured: pe of grout (circle one): Neat Cem inches Type of screen: feet to	Other:

RECEIVED

APR 2 5 2012 BY: OLWR


The sketch below only required for water wells

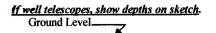

Description of formations encountered must be provided for all wells and boreholes, unless specifically exempted by regulations

Description of Formations Encountered	From (depth)	To (depth)
	Ground Level	
Clay-	0	20
Santa	20	69
Clust	40	50
Sand	50	60
course sand	60	75
		1
······································		
		1
	I	
		1
		1
	·····	

If more than one screen, show location of each on sketch

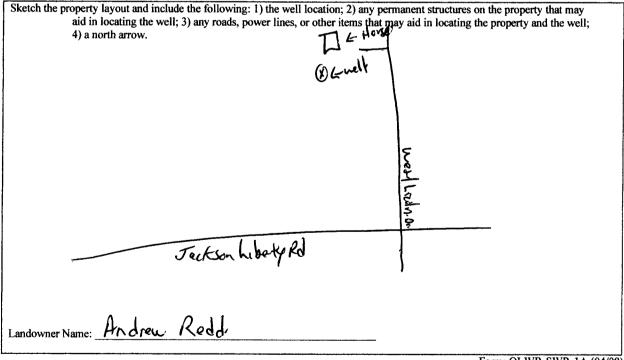

Form: OLWR-SWR-1A (04/08)

I certify that the well/borehole was drilled, constructed, and completed in accordance with all applicable requirements of the Mississippi Department of Environmental Quality and the Mississippi Department of Health regulations, if applicable, and state

O29.

laws. Brad Fitzerelld

Print Name of Responsible Licensee and License No.

1-6-12 Date

Signature of Licensee

RECEIVED

APR 2 5 2012

BY: OLWR

County: Liceln Permit #: Driller: Fitzpera Id Utell Server Date completed: <u>Y-6-i2</u> . Copy information from block on Part 1 Pump Installer Mississippi Departur Office of Lan 0 0 0 0 0 0 0 0 0 0 0 0 0	VELL REPORT Part 2 er's Completion Report nent of Environmental Quality nd and Water Resources 0. Box 2309 son, MS 39225 01)961-5210 0961-5228 (fax) ell contractor or a licensed pump installer. A copy of Part 1 of the et at the above address within 30 days of well completion. Well Location
Owner Name: Andrew Redd, Mailing Address: West Liccily Dr.	Latitude: <u>31° 28′ 18″</u> Longitude: <u>90° 35′ 6.1</u> ″ Method of Lat/Long (check one): Conventional Survey,
Boroch to MS City State Zip Code	USGS quad, Hand-held GPS, Survey-grade GPS ¼¼ Sec 22 T SN_R_GE Distance Direction Nearest Town Milesof
Pump Type Circle one Air Lift Jet Bucket Piston Turbine	Power Type Circle one Diesel Engine Gasoline Engine Natural Gas Electric Motor Hand Tractor PTO
Centrifugal Rotary Flowing Well	Windmill Other (specify): Horse Power Rating of Motor:
Other (specify): Date Pump Installed: $\underline{4-6-12}$. Rated Pump Capacity:Gallons Per Minute	Setting Depth: <u>70</u> feet Number of Stages: <u>14</u>
Pump Test Data Date Well Tested:	Method of Measuring Water Level Circle one Air Line Electric Measuring Line Line Other (specify):
This is for (circle one): Kew Well Replacement of E	Existing Pump Repair of Existing Pump

4 ¹ ¹

APR 2 5 2012 BY: OLWR