
Śtate W	ell Report		
	art 1	For Office Use Only:	
County: <u>C) ///////////////////////////////////</u>	t of Environmental Quality	Aquifer:	
Permit #: Office of Land a	nd Water Resources	Well #:K133	
	lox 10631 (S 39289-0631	L. S. Elevation:	
SUPPLY, INC. Jackson, M. Date drilling completed: <u>12-6-12</u> (601)	961-5210	L. S. Elévation:	
A state of the second sec	4-6938 (fax)	B-log #:	
	dellar in datail and filed u	with the Department within	
State Law requires that this report be prepared by the 30 days of completion of drilling of the well.	armer m actan and med v		
Well Owner Information	Wel	ll Location	
Owner Name_Neil Case	Latitude: <u>31 • 31-'215</u>	-" Longitude: <u>90°32.'987</u> " 59	
Mailing Address: 1211 George Tr.	Method of Lat/Long (circle o		
	USGS quad, Hand-hel	d GPS, Survey-grade GPS	
Braskhauen, Ms. 39601 City State Zip Code	SE 4 NE 4 Sec_	Twn 6 Ar Rng 6 E	
Telephone No. (\cancel{GOL}) 32° - $180^{\circ}2$.	Distance Direction $\underline{-7}^{-}$ Miles $\underline{-5}^{-}$	Nearest Town of <u>Brockhaven</u>	
Well	Data		
Purpose of Well (circle one) Home Industrial Public Supply	Irrigation Fish Culture		
Date well drilling started: $12-6-12$ Date		2-6-12	
If flowing, method of flow regulation: Valve Other (describe)		
Static Water Level: feet above or below (circle one)	land surface Date measured	12-6-12	
Method of Measurement (circle one) steel tape electric tap			
Hole depth: <u>182</u> Well depth: <u>177</u>	_ Well grouted to a depth of		
-Type of grout (circle one): Cement Bentonite Mix			
Casing length: <u>167</u> feet Casing diameter: <u>4</u>			
Screen length: 10 feet Screen diameter:	inches Type of screen:		
Screen slot size: <u>,010</u> inches Setting depth: From	feet to	foot	
Type of completion (circle all applicable): Gravel packed Under	erreamed Telescoped Op	en hole Natural Development	
Other (describe):	······		
Top of lap pipe or reduction in casing:feet. If	telescoped or more than one s	creen, describe on back of page	
Logs run (circle all applicable): No log run Electric Gamma Ra	y Density Sonic Neutron	Other:	
Name of organization running log(s):		to me and in case of the Mitchedrami	
I certify that the well was drilled, constructed, and completed in			
Department of Environmental Quality and/or the Mississippi De	epartment of Health regulatio	ns and state laws.	
GRENN WATER WELL & SUPPLY, INC.	R. +	Mglendon	
Brian McClendon, lic. no. 0-664			
Print Name of Water Well Contractor and License No.	Signature	of Water Well Contractor	
	-	. RECENT	
		JAN 0 · 3 2013	
	•	UMIN 0 0 2010	
		A A A A A A A A A A A A A A A A A A A	

BY: OLWR

If well telescopes please sketch below and show depths.

Ground Level	Description of Formations Encountered	From	То
	red clay	O I	10
	sound streaks	10	40
	sand tgravel	40	64
	white chy	64	85
	blue chy	-85	135
	stleaky	135	152
	sand	130	178
	white cky	178	182

If more than one screen, show location of each on sketch

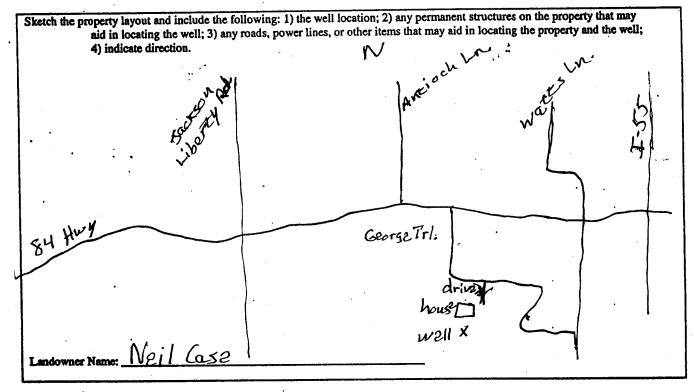

en 664 Signature of Water Well Contractor

Brian McClendon, lic. no. 0-664 GRENN WATER WELL & SUPPLY, INC.

			ELL REPORT			
County:		Pump Installer Mississippi Departm	Part 2 r's Completion Report ent of Environmental Quality d and Water Resources	For Office Use Only: Aquifer:		
Driller: GRENN WA		P.O	. Box 10631 , MS 39289-0631	Weil #:K 133_ Elevation:		
& SUPPLY Date completed: 12	10/12	(60	1)961-5210			
			354-6938 (fax)			
installation of p	ump.		tail and filed with the Departme	ent within 30 days of the		
	Vell Owner Info		Well Location			
Owner Name:			Latitude: $31^{0}31^{2}215^{\prime\prime}$ Longitude: 90 $32^{\prime}937^{\prime}$			
Mailing Address:	211 Ge	orge Trl	Method of Lat/Long (circle or	Method of Lat/Long (circle one): Conventional Survey,		
			USGS quad, Hand	I-held GPS Survey-grade GPS		
<u>B</u> .	100 kharen	M5 39601 ate Zip Code	<u>SE 1/4 NE 1/4 Sec_1</u>	SE 1/4 NE 1/4 Sec 1 Twn 6N Rng 6E		
Ch	y St	ate Zip Code	Distance Direction	Distance Direction Nearest Town		
Telephone No. (601) 320 - 1802		7 Miles SW of Brookhaver				
Pump Type Circle one		Power Type Circle one				
Air Lift	Jet	Submersible >		ne Engine Natural Gas		
Bucket	Piston	Turbine	Electric Motor Hand			
Centrifugal	Rotary	Flowing Well	Windmill Other	(specify):		
Other (specify):	<u> </u>		Horse Power Rating of Motor			
Date Pump Installed:	12/10	/12	Setting Depth:/00			
Rated Pump Capacity		Gallons Per Minute	Number of Stages:9	twt		
Pump Test Data Date Well Tested: 12/10/12			asuring Water Level			
		Circle one				
Static Water Level (A): <u>67</u> Feet Below Land Surface			suring Line Steel Tape			
Pumping Water Level	(B): <u>72</u>	Feet Below Land Surface	Other (specify):			
Drawdown [(B) - (A)	<u> 5 </u>	Feet Below Land Surface	For flowing well, measured sh	nut in head: feet		
Test Pumping Rate: 14 Gallons Per Minute			Well yielded <u>14</u> GPM with a drawdown of			
Duration of Pump Test (minimum 4 hours): hours				<u> </u>		

4

I HEREBY CERTIFY that the above statements are true to the best of	f my knowledge.	
WILLIAM L. HARDIN, V, UNR-00000802	William Hayding	
Print Name of Pump Installer and License No. (if applicable)	Signature of Pump Installer	
	organizatio of 1 millip Instante	RECEMEN
		RE(FINED)
		LANT 0 9 9010

JAN 0 3 2013 BY: OLWR