

# State Well Report

## Part 1

Mississippi Department of Environmental Quality  
Office of Land and Water Resources  
P.O. Box 10631  
Jackson, MS 39289-0631  
(601)961-5210  
(601)354-6938 (fax)

County: Lincoln  
Permit #: \_\_\_\_\_  
Driller: GRENN WATER WELL & SUPPLY, INC.  
Date drilling completed: 2-27-13

For Office Use Only:  
Aquifer: \_\_\_\_\_  
Well #: K135  
L. S. Elevation: \_\_\_\_\_  
E-log #: \_\_\_\_\_

State Law requires that this report be prepared by the driller in detail and filed with the Department within 30 days of completion of drilling of the well.

Well Owner Information	Well Location
Owner Name: <u>Joseph Evans</u>	Latitude: <u>31° 28' 31.7"</u> Longitude: <u>90° 33' 48.5"</u>
Mailing Address: <u>1245 Roberts Ln SW</u>	Method of Lat/Long (circle one): Conventional Survey, <u>Hand-held GPS</u> , Survey-grade GPS
<u>Brookhaven MS 39601</u>	USGS quad, <u>NE 1/4 NW 1/4 Sec 24 Twn 6N Rng 6E</u>
City: _____ State: _____ Zip Code: _____	Distance: <u>1.5</u> Miles Direction: <u>SE</u> Nearest Town: <u>West Lincoln</u>
Telephone No. <u>(775) 217-1465</u>	

**Well Data**

Purpose of Well (circle one): Home Industrial Public Supply Irrigation Fish Culture Other: \_\_\_\_\_

Date well drilling started: 2-27-13 Date well drilling completed: 2-27-13

If flowing, method of flow regulation: Valve \_\_\_\_\_ Other (describe) \_\_\_\_\_

Static Water Level: 28 feet above or below (circle one) land surface Date measured: 2-27-13

Method of Measurement (circle one) steel tape electric tape air line other: \_\_\_\_\_

Hole depth: 53 Well depth: 49 Well grouted to a depth of 10 feet

Type of grout (circle one): Cement Bentonite Mix

Casing length: 29 feet Casing diameter: 4 inches Type of casing: PVC

Screen length: 20 feet Screen diameter: 4 inches Type of screen: PVC

Screen slot size: .010 inches Setting depth: From 29 feet to 49 feet

Type of completion (circle all applicable): Gravel packed Underreamed Telescoped Open hole Natural Development

Other (describe): \_\_\_\_\_

Top of lap pipe or reduction in casing: \_\_\_\_\_ feet. If telescoped or more than one screen, describe on back of page

Logs run (circle all applicable): No log run Electric Gamma Ray Density Sonic Neutron Other: \_\_\_\_\_

Name of organization running log(s): \_\_\_\_\_

I certify that the well was drilled, constructed, and completed in accordance with all applicable requirements of the Mississippi Department of Environmental Quality and/or the Mississippi Department of Health regulations and state laws.

GRENN WATER WELL & SUPPLY, INC.  
BRIAN D. McCLENDON, UNR-00000664

Print Name of Water Well Contractor and License No. Brian McCleendon  
Signature of Water Well Contractor


RECEIVED  
MAR 12 2013  
BY: OLWR

If well telescopes please sketch below and show depths.

Ground Level


Description of Formations Encountered	From	To
red clay	0	14
sand & gravel	14	48
white clay	48	53

If more than one screen, show location of each on sketch

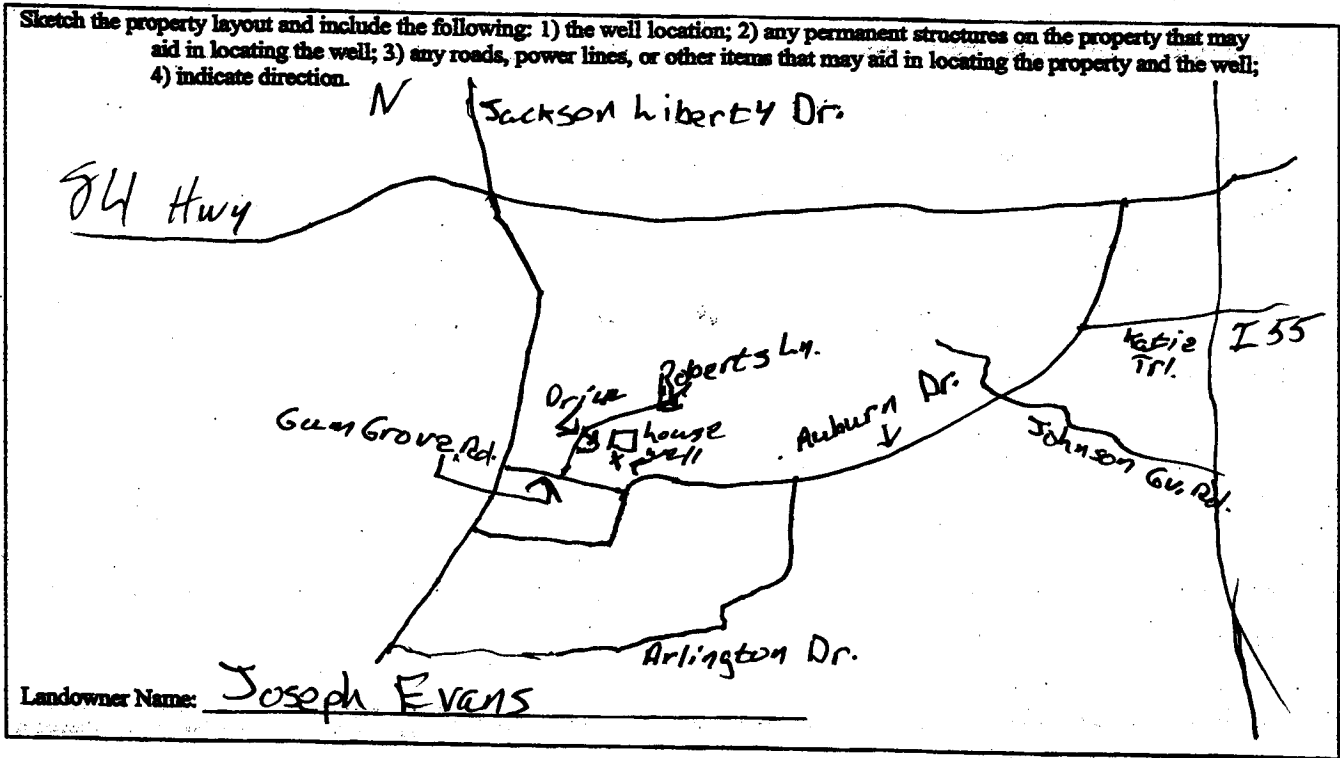

~~Signature~~ Brian McClendon 664  
 Signature of Water Well Contractor

# STATE WELL REPORT

## Part 2

**Pump Installer's Completion Report**  
 Mississippi Department of Environmental Quality  
 Office of Land and Water Resources  
 P.O. Box 10631  
 Jackson, MS 39289-0631  
 (601)961-5210  
 (601)354-6938 (fax)

County: Lincoln  
 Permit #: \_\_\_\_\_  
 Driller: GRENN WATER WELL & SUPPLY, INC.  
 Date completed: 2-28-13

**For Office Use Only:**

Aquifer: \_\_\_\_\_  
 Well #: K135  
 Elevation: \_\_\_\_\_

**This report should be prepared by the pump installer in detail and filed with the Department within 30 days of the installation of pump.**

Well Owner Information	Well Location
Owner Name: <u>Joseph Evans</u>	Latitude: <u>31° 28' 31"</u> Longitude: <u>90° 33' 68.5"</u>
Mailing Address: <u>1245 Roberts Ln SW</u>	Method of Lat/Long (circle one): Conventional Survey,
_____ <u>Brookhaven ms 39601</u> City State Zip Code	USGS quad, <u>Hand-held GPS</u> , Survey-grade GPS
Telephone No. <u>(775) 217-1465</u>	<u>NE</u> ¼ <u>NW</u> ¼ Sec <u>24</u> Twn <u>6N</u> Rng <u>6E</u>
	<u>NW</u> <u>SW</u> Distance Direction Nearest Town <u>1.5</u> Miles <u>SF</u> of <u>West Lincoln</u>

Pump Type Circle one	Power Type Circle one
Air Lift Jet <u>Submersible</u>	Diesel Engine Gasoline Engine Natural Gas
Bucket Piston Turbine	<u>Electric Motor</u> Hand Tractor PTO
Centrifugal Rotary Flowing Well	Windmill Other (specify): _____
Other (specify): _____	Horse Power Rating of Motor: <u>1/2</u>
Date Pump Installed: <u>2/28/13</u>	Setting Depth: <u>48</u> feet
Rated Pump Capacity: <u>10</u> Gallons Per Minute	Number of Stages: <u>9</u>

Pump Test Data	Method of Measuring Water Level Circle one
Date Well Tested: <u>2/28/13</u>	Air Line <u>Electric Measuring Line</u> Steel Tape
Static Water Level (A): <u>28</u> Feet Below Land Surface	Other (specify): _____
Pumping Water Level (B): <u>35</u> Feet Below Land Surface	For flowing well, measured shut in head: <u>7</u> feet
Drawdown [(B) - (A)]: <u>7</u> Feet Below Land Surface	Well yielded <u>14</u> GPM with a drawdown of
Test Pumping Rate: <u>14</u> Gallons Per Minute	<u>7</u> feet after <u>4</u> hours of pumping
Duration of Pump Test (minimum 4 hours): <u>4</u> hours	

I HEREBY CERTIFY that the above statements are true to the best of my knowledge.  
 WILLIAM L. HARDIN, V, UNR-00000802  
 Print Name of Pump Installer and License No. (if applicable)

William Hardin  
 Signature of Pump Installer

RECEIVED

MAR 12 2013

BY: OLWR