
	State W	all Deport				
		ell Report	For Office Use Only:			
county: Lincoln		art 1	Aquifar			
Permit #:		Sississippi Department of Environmental Quality Aquifer:				
GRENN WATER WELL &	P.O. E	lox 10631	Well #:K 140			
Driller: SUPPLY, INC.		S 39289-0631	L. S. Elevation:			
Date drilling completed: $5/8/13$		961-5210	77.1			
	(001)334	1-6938 (fax)	E-log #:			
	State Law requires that this report be prepared by the driller in detail and filed with the Department within 30 days of completion of drilling of the well.					
Well Owner Informa		Wel	Location			
Owner Name Go and Oliver		Latitude: 31 ° 24 . 90	" Longitude: 90° 36'. 7#1"			
	Owner Name Gary Quinn		Latitude: <u>31° 26, '909</u> " Longitude: <u>90° 36' 771</u> " 54 45			
Mailing Address: 7/16 W.T. Hall Rol.		Method of Lat/Long (circle one): Conventional Survey,				
		USGS quad, Hand-held	GPS, Survey-grade GPS			
Ethol -0-7	Ethel, La. 70730 City, State Zip Code		Sid 1/4 NW1/4 Sec 33 Twn 6 Nor Rng 6E			
City Sta	te Zip Code					
Telephone No. (225 405-35)	2	Distance Direction	of Boque Chitto			
Telephone No. $(21.5)$ $(23.5)$			pulle 20. 200			
Well Data						
Purpose of Well (circle one) Home Inc			4			
Date well drilling started: $5 - 8 - 13$ Date well drilling completed: $5 - 8 - 13$						
If flowing, method of flow regulation: Valve Other (describe)						
Static Water Level:						
Method of Measurement (circle one) steel tape electric tape air line other:						
Hole depth: <u>97</u> Well depth: <u>95</u> Well grouted to a depth of <u>1D</u> feet						
Type of grout (circle one): Cement Rentonite Mix						
Casing length: <u>85</u> feet Casing diameter: <u>W</u> inches Type of casing: <u>PVC</u>						
Screen length: <u>10</u> feet Screen diameter: <u>4</u> inches Type of screen: <u>PVC</u>						
Screen slot size: <u>1010</u> inches Setting depth: From <u>85</u> feet to <u>95</u> feet						
Type of completion (circle all applicable): Gravel packed Underreamed Telescoped Open hole Natural Development						
	Other (describe):					
Top of lap pipe or reduction in casing:	feet. If t	elescoped or more than one sc	reen, describe on back of page			
Logs run (circle all applicable): No log r	Electric Gamma Ra	y Density Sonic Neutron	Other:			
Name of organization running log(s):						
I certify that the well was drilled, constructed, and completed in accordance with all applicable requirements of the Mississippi						
Department of Environmental Quality and/or the Mississippi Department of Health regulations and state laws.						
GRENN WATER WELL & SUPP			Acros 1 1			
	R-00000664	Brian Il	1- Xentron 1			
Print Name of Water Well Contractor and License No. Signature of Water Well Contractor						
			RECEIVED			
			MAY <b>31</b> 2013			
			BY: OLWP			

## K140

If well telescopes please sketch below and show depths.

Ground Level		Description of Formations Encountered	From	То
		- red chy	0	
		white clay	30	50
		sand to gravel	50	93
		Yellow clay	- 95	97
-	×			<u> </u>
				<u> </u>
				<b> </b>

If more than one screen, show location of each on sketch

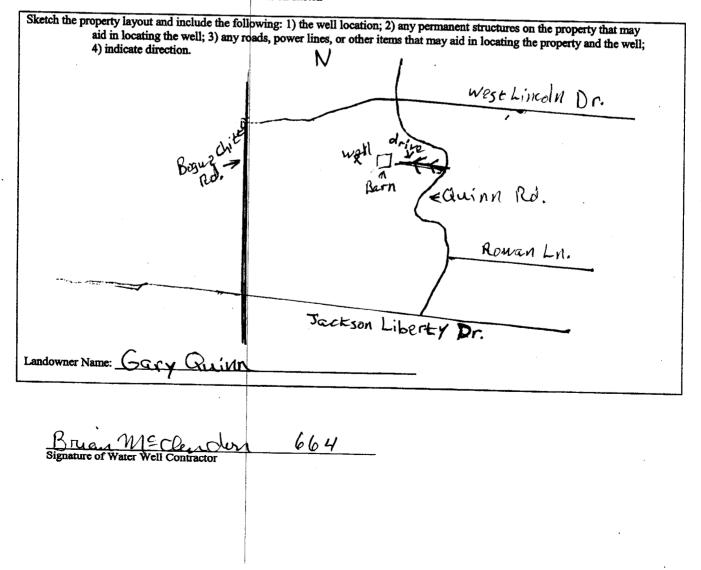

STATE WELL REPORT					
County:  Lincoln    Permit #:	Part 2    For Office Use Only:      's Completion Report    Aquifer:      and Water Resources    Aquifer:      Box 10631    Well #:    K14C      1961-5210    Elevation:    Elevation:				
This report should be prepared by the pump installer in detail and filed with the Department within 30 days of the installation of pump.					
Well Owner Information	Well Location				
Owner Name: Gary Quin	Latitude: <u>31°26 909</u> "Longitude: <u>90°36 747</u> "				
Mailing Address: 7116 W.T. Hall Rd	Method of Lat/Long (circle one): Conventional Survey,				
<u>Ethel La. 70730</u> City State Zip Code Telephone No. (225) 405-3512	USGS quad, $\underbrace{\operatorname{Eand-held GPS}}_{\text{Survey-grade GPS}}$ Survey-grade GPS $\underbrace{\underline{SW}  \underline{NW}  \underline{NW}  \underline{Sec  33}}_{\text{Twn}  \underline{6N}  \operatorname{Rng}  \underline{6E}}_{\text{Distance}}$ Distance Direction Nearest Town $\underbrace{\underline{9}  \underline{Miles}  \underline{W}  \underline{of}  \underline{BogWc  Ch},  \underline{H_6}}_{\text{Og}Wc  \underline{Ch},  \underline{H_6}}$				
Pump Type Circle one	Power Type Circle one				
Air Lift Jet Submersible	Diesel Engine Gasoline Engine Natural Gas				
Bucket Piston Turbine	Electric Motor Hand Tractor PTO				
Centrifugal Rotary Flowing Well	Windmill Other (specify):				
Other (specify):	Horse Power Rating of Motor:				
Date Pump Installed: <u>5/9/13</u>	Setting Depth: <u>90</u> feet				
Rated Pump Capacity: Gallons Per Minute	Number of Stages:				
Pump Test Data	Method of Measuring Water Level				
Date Well Tested:5/9/13	Circle one Air Line Electric Measuring Line Steel Tane				
Static Water Level (A): 59 Feet Below Land Surface	Succession of the second secon				
Pumping Water Level (B): <u>65</u> Feet Below Land Surface	Other (specify):				
Drawdown [(B) - (A)]:Feet Below Land Surface	For flowing well, measured shut in head:feet				
Test Pumping Rate: 13 Gallons Per Minute	Well yielded GPM with a drawdown of				
Duration of Pump Test (minimum 4 hours): hours	7_feet after4 hours of pumping				
I HEREBY CERTIFY that the above statements are true to the best of my knowledge. WILLIAM L. HARDIN, V, UNR-00000802 Print Name of Pump Installer and License No. (if applicable) Signature of Pump Installer					

.

٠

.

•

MAY **31** 2013

BY: OLWR