

Lincoln
R 2000
10-27-75

MISSISSIPPI
 BOARD OF WATER COMMISSIONERS
 416 North State Street
 Jackson, Mississippi 39201

WATER WELL DRILLERS LOG


Oct. 27 19 75 Grenn Water Well Contr. Lincoln
 date well completed firm name county well located

LANDOWNER: <u>Juanita Achord</u> <u>Rt. 2, Box 44</u> <u>Brookhaven, Miss.</u> (mailing address)	description of formations encountered	from	to
	<u>Citronelle</u>	<u>0</u>	<u>76</u>
WELL LOCATION:			
sec. <u>15</u> T. <u>6</u> N. R. <u>6</u> E. ¹³⁴ <u>9</u> miles SW of <u>Brookhaven</u> (distance) (direction) (nearest town)			
WELL PURPOSE: <u>home</u> (home, irrigation, municipal, industrial)			
WELL COMPLETION DATA:			
(1) diameter (inches) <u>6</u>			
(2) total depth (feet) <u>76</u>			
(3) static water level (feet) <u>50</u> below top of ground. above			
(4) casing <u>PVC</u> <u>70</u> (material) (depth) <u>4"</u> (size) If telescope see back.			
(5) screen <u>6'</u> <u>70'</u> (length) (depth to top) <u>.010</u> <u>PVC</u> (size) (material)			
(6) pump <u>did not install</u> (HP) (yield gpm)			
(type power)			
(7) electric log <u>no</u> (yes or no)			
(organization running log)			
(8) how well bottom plugged <u>wood</u>			
DRILLERS REMARKS:			

MISSISSIPPI BOARD OF WATER COMMISSIONERS
 416 NORTH STATE STREET
 JACKSON, MISSISSIPPI 39201
 OCT 27 1975
 MISS. Bd. of Water Comm.

If well telescopes please sketch and show depths.

GROUND LEVEL

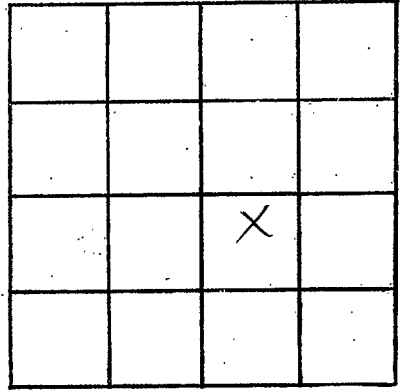

SECTION 15

Please indicate well location X.

ADDITIONAL INFORMATION

If more than one screen, show locations of each on sketch.