

LINCOLN  
R 2001  
12-31-75

MISSISSIPPI  
 BOARD OF WATER COMMISSIONERS  
 416 North State Street  
 134 Jackson, Mississippi 39201

WATER WELL DRILLERS LOG


Dec 31 1975 Reems Well Service Lincoln  
 date well completed firm name county well located

LANDOWNER:	description of formations encountered	from	to
<u>Harold Wall</u>			
<u>Rt 4 Bogalitto</u> (mailing address)	<u>clay</u> <u>cherty sand</u> <u>green sand</u>	<u>0</u> <u>21</u> <u>56</u>	<u>21</u> <u>56</u> <u>70</u>
<b>WELL LOCATION:</b>			
sec <u>36</u> T <u>6</u> N R <u>6</u> E <u>6 1/2</u> miles <u>west</u> of <u>Bogalitto</u> (distance) (direction) (nearest town)			
<b>WELL PURPOSE:</b> <u>house</u> (home, irrigation, municipal, industrial)			
<b>WELL COMPLETION DATA:</b>			
(1) diameter (inches) <u>1 1/2"</u>			
(2) total depth (feet) <u>70</u>			
(3) static water level (feet) <u>47</u> below top of ground.			
(4) casing <u>plastic, bottom</u> (material) (depth)			
<u>        </u> (size) if telescope see back.			
(5) screen <u>6"</u> <u>6 1/2'</u> (length) (depth to top)			
<u>1/2"</u> <u>plastic</u> (size) (material)			
(6) pump <u>1/2</u> <u>5</u> (HP) (yield gpm)			
<u>sheet</u> (type power)			
(7) electric log <u>no</u> (yes or no)			
<u>        </u> (organization running log)			
(8) how well bottom plugged <u>wooden plug</u>			
DRILLERS REMARKS: <u>new house</u>			

RECEIVED  
 MAR 6 1976

If well telescopes please sketch and show depths.

GROUND LEVEL

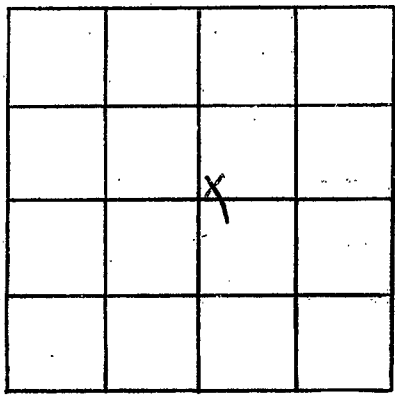

SECTION 36

Please indicate well location X.

ADDITIONAL INFORMATION

Lined area for additional information.

If more than one screen, show locations of each on sketch.