

Lincoln
 K 2003
 2-16-76

MISSISSIPPI
 BOARD OF WATER COMMISSIONERS
 416 North State Street
 Jackson, Mississippi 39201

WATER WELL DRILLERS LOG

Feb 16 1976 *Recessall Service, Lincoln*
 date well completed firm name county well located

LANDOWNER:
Needell Robinson
Rt 4 ~~Bone~~ Boue Chitto
 (mailing address)

description of formations encountered	from	to
<i>Red Clay</i>	<i>0</i>	<i>2.2</i>
<i>Red Cherty sand</i>	<i>2.2</i>	<i>6.5</i>
<i>fine gravel sand</i>	<i>6.5</i>	<i>8.1</i>

WELL LOCATION:
 sec. *36* T-*6* N R-*6* E
6 1/2 miles *west* of *Boue Chitto*
 (distance) (direction) (nearest town)

WELL PURPOSE: *home*
 (home, irrigation, municipal, industrial)

- WELL COMPLETION DATA:
- (1) diameter (inches) *1 1/2"*
 - (2) total depth (feet) *81*
 - (3) static water level (feet) *50* below top of ground.
 - (4) casing *plastic bottom*
 (material) (depth)
 - (5) screen *6'* *75*
 (length) (depth to top)
 - 4"* *plastic*
 (size) (material)
 - (6) pump *used* *4*
 (HP) (yield gpm)
 - elect*
 (type power)
 - (7) electric log *no*
 (yes or no)
- (organization running log)


(8) how well bottom plugged
Wood plug

DRILLERS REMARKS:
none

MAY 10 1976

If well telescopes please sketch and show depths.

GROUND LEVEL

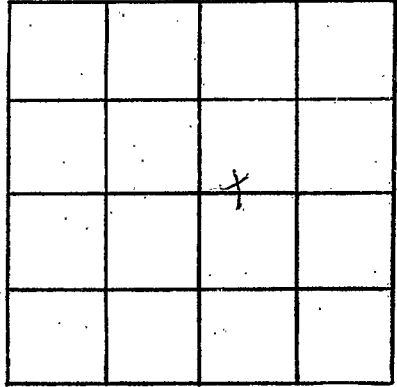

SECTION 36

Please indicate well location X.

ADDITIONAL INFORMATION

If more than one screen, show locations of each on sketch.