

Lincoln
R 2004
3-24-76


MISSISSIPPI
 BOARD OF WATER COMMISSIONERS
 416 North State Street
 Jackson, Mississippi 39201

WATER WELL DRILLERS LOG

Mar 24 1976 Grenn Waterl Well Con. Lincoln

date well completed firm name county well located


LANDOWNER:	description of formations encountered	from	to
Raymond Bröcker Rt. 1, Box 229A McComb, Miss. 39648 (mailing address)	Citronelle	1	71
WELL LOCATION:			
sec <u>3</u> T <u>6</u> N R <u>6</u> E S W			
6 miles SW of Brookhaven (distance) (direction) (nearest town)			
WELL PURPOSE: home (home, irrigation, municipal, industrial)			
WELL COMPLETION DATA:			
(1) diameter (inches) <u>4"</u>			
(2) total depth (feet) <u>71</u>			
(3) static water level (feet) <u>45</u> below top of ground. above			
(4) casing <u>PVC</u> <u>59'</u> (material) (depth)			
<u>4"</u> (size) if telescope see back.			
(5) screen <u>12'</u> <u>59'</u> (length) (depth to top)			
<u>.010</u> <u>PVC</u> (size) (material)			
(6) pump <u>1/2</u> sub <u>10</u> (HP) (yield gpm) <u>electricity</u> (type power)			
(7) electric log <u>no</u> (yes or no)			
<u>(organization running log)</u>			
(8) how well bottom plugged <u>wood</u>			
DRILLERS REMARKS:			

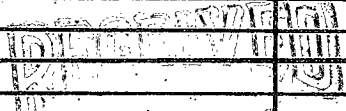

MAY 7 1976

If well telescopes please sketch and show depths.

GROUND LEVEL

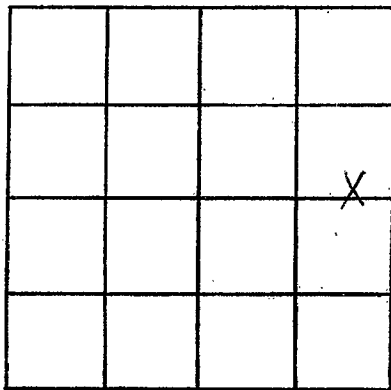

SECTION 3

Please indicate well location X.

ADDITIONAL INFORMATION

Horizontal lines for additional information.

If more than one screen, show locations of each on sketch.