

LINCOLN
K 2007
12-16-76

MISSISSIPPI
 BOARD OF WATER COMMISSIONERS
 416 North State Street
 Jackson, Mississippi 39201

WATER WELL DRILLERS LOG


Dec. 16 1976 Grenn Water Well Lincoln
 date well completed firm name county well located

LANDOWNER:	description of formations encountered	from	to
Eugene Upton, Jr. 927 Williams St. Brookhaven, Miss. (mailing address)			
	White clay	10	35
	blue clay	35	55
	white clay	55	75
	sand	75	138
WELL LOCATION:			
sec. 9 T. 6 N R. 6 E			
9 miles SW of Brookhaven (distance) (direction) (nearest town)			
WELL PURPOSE: home (home, irrigation, municipal, industrial)			
WELL COMPLETION DATA:			
(1) diameter (inches) 6"			
(2) total depth (feet) 138			
(3) static water level (feet) 70 below top of ground.			
(4) casing PVC, 126" (material) (depth)			
4" if telescope see back. (size)			
(5) screen 12" 126" (length) (depth to top)			
.010 P" VC (size) (material)			
(6) pump did not install (HP) (yield gpm)			
(type power)			
(7) electric log no (yes or no)			
(organization running log)			
(8) how well bottom plugged back wash valve			
DRILLERS REMARKS:			

RECEIVED
 JAN 24 1971
 S. CO. OF WATER COMMISSIONERS

If well telescopes please sketch and show depths.

GROUND LEVEL

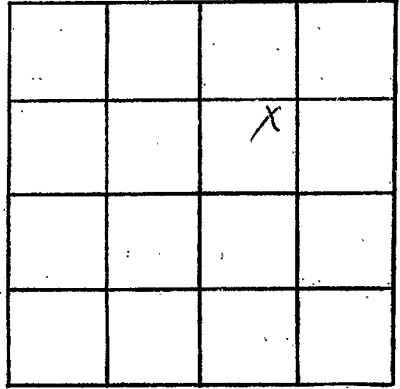

SECTION 9

Please indicate well location X.

ADDITIONAL INFORMATION

If more than one screen, show locations of each on sketch.