

Lincoln  
K 2008  
2-15-77

MISSISSIPPI  
 BOARD OF WATER COMMISSIONERS  
 416 North State Street  
 Jackson, Mississippi 39201

WATER WELL DRILLERS LOG

Feb. 15 1977 Grenn Water Well Cont. Lincoln  
 date well completed firm name county well located

LANDOWNER: C. M. Terry	description of formations encountered	from	to			
P.O. Box 301				Clay & gravel	1	20
Brookhaven, Miss. (mailing address)				white clay	20	50
				blue clay	50	79
				sand	79	123

WELL LOCATION:  
 sec. 4 T 6 N R 6 E  
 S W  
 9 miles SW of Brookhaven  
 (distance) (direction) (nearest town)

WELL PURPOSE: home  
 (home, irrigation, municipal, industrial)

- WELL COMPLETION DATA:
- (1) diameter (inches) 6
  - (2) total depth (feet) 123
  - (3) static water level (feet) 50 below top of ground.
  - (4) casing PVC 117' (material) (depth)  
 4" (size) If telescope see back.
  - (5) screen 6' 117' (length) (depth to top)  
 .010 (size) PVC (material)
  - (6) pump 1/2 sub 10 (HP) (yield gpm)  
 electricity (type power)
  - (7) electric log no (yes or no)

(organization running log)

(8) how well bottom plugged back wash valve

DRILLERS REMARKS:


RECEIVED

MAR 25 1977

MISS. BD. OF WATER COMMISSIONERS

If well telescopes please sketch and show depths.

GROUND LEVEL

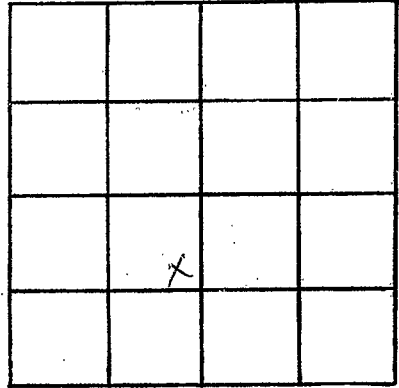

SECTION 4

Please indicate well location X.

ADDITIONAL INFORMATION

If more than one screen,  
show locations of each on sketch.