

Lincoln  
K 2010  
6-8-77

MISSISSIPPI  
BOARD OF WATER COMMISSIONERS  
416 North State Street  
Jackson, Mississippi 39201

WATER WELL DRILLERS LOG

June 8, 1977 Grenn Water Well Cont. Lincoln  
date well completed firm name county well located


LANDOWNER: <u>Bob Mosley</u>	description of formations encountered	from	to
P.O. Box 1148			
Brookhaven, Miss.	sand & gravel	20	32
(mailing address)	white clay	32	50
WELL LOCATION:	blue clay	50	95
sec. <u>9</u> T. <u>6</u> N R. <u>6</u> E	sand	95	152
<u>12 6 ±</u> miles SW of Brookhaven			
(distance) (direction) (nearest town)			
WELL PURPOSE: <u>home</u>			
(home, irrigation, municipal, industrial)			
WELL COMPLETION DATA:			
(1) diameter (inches) <u>6</u>			
(2) total depth (feet) <u>152</u>			
(3) static water level (feet) <u>95</u> <u>below</u> top of ground.			
(4) casing <u>PVC</u> , <u>140</u>			
(material) (depth)			
<u>4"</u> If telescope see back.			
(size)			
(5) screen <u>12'</u> , <u>140'</u>			
(length) (depth to top)			
<u>.010</u> <u>PVC</u>			
(size) (material)			
(6) pump <u>did not install</u>			
(HP) (yield gpm)			
(type power)			
(7) electric log <u>no</u>			
(yes or no)			
(organization running log)			
(8) how well bottom plugged <u>back wash valve</u>			
DRILLERS REMARKS:			

RECEIVED  
AUG 24 1977

MISS. BD. OF WATER COMMISSIONERS

If well telescopes please sketch and show depths.

GROUND LEVEL

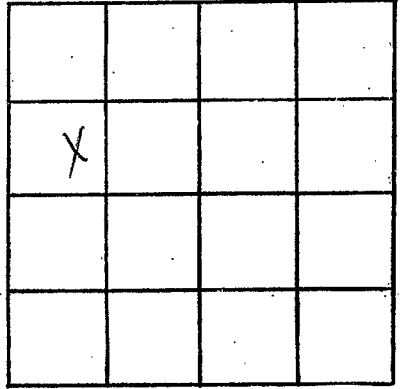

SECTION 9

Please indicate well location X.

ADDITIONAL INFORMATION

If more than one screen, show locations of each on sketch.