

LINCOLN
K 2011
6-17-77

MISSISSIPPI
BOARD OF WATER COMMISSIONERS
416 North State Street
Jackson, Mississippi 39201

WATER WELL DRILLERS LOG

June 17 1977 Covington Lincoln
date well completed firm name county well located

LANDOWNER: James Ross
Brookhaven
(mailing address)

description of formations encountered	from	to
CLAY	0	14
SAND	14	16
PIPE CLAY	16	60
PACKY SAND	60	94
SAND	94	108

WELL LOCATION:
sec. 9 T. 6 N. R. 6 E
13 miles W of Brookhaven
(distance) (direction) (nearest town)

WELL PURPOSE: Home
(home, irrigation, municipal, industrial)

WELL COMPLETION DATA:


(1) diameter (inches) 4
(2) total depth (feet) 108
(3) static water level (feet) 65 below top of ground.
(4) casing PASTIC (material) (depth)
4 if telescope see back. (size)
(5) screen 7 101 (length) (depth to top)
4 PASTIC (size) (material)
(6) pump 1/2 5 (HP) (yield gpm)
(type power)
(7) electric log (yes or no)
(organization running log)
(8) how well bottom plugged Wood

DRILLERS REMARKS:

RECEIVED
AUG 10 1977

If well telescopes please sketch and show depths.

GROUND LEVEL

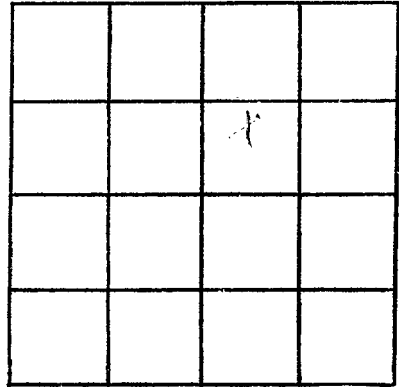

SECTION 9

Please indicate well location X.

ADDITIONAL INFORMATION

If more than one screen,
show locations of each on sketch.