

69

Lincoln
K 2012
6/20/77

MISSISSIPPI
BOARD OF WATER COMMISSIONERS
416 North State Street
Jackson, Mississippi 39201

Robert Miller
WATER WELL DRILLERS LOG

June 20 19 77 ~~Ernestine Delaney~~ Lincoln
date well completed firm name county well located

LANDOWNER:
Ernestine Delaney
Rt Smith Dale
(mailing address)

description of formations encountered	from	to
<i>Clay</i>	0	10
<i>Red sand</i>	10	48
<i>sand & gravel</i>	48	56

WELL LOCATION:
sec. 32-T-6 N R-6 E
5 1/2 miles north of Auburn
(distance) (direction) (nearest town)

WELL PURPOSE: *Tractor*
(home, irrigation, municipal, industrial)

- WELL COMPLETION DATA:
- (1) diameter (inches) 4"
 - (2) total depth (feet) 56
 - (3) static water level (feet) 40 below top of ground.
 - (4) casing plastic bottom
(material) (depth)
 - (size) if telescope see back.
 - (5) screen 5" 51
(length) (depth to top)
 - 4" plastic
(size) (material)
 - (6) pump 1 1/2 1.0
(HP) (yield gpm)
 - split
(type power)
 - (7) electric log no
(yes or no)
 - (organization running log)


(8) how well bottom plugged
wooden
DRILLERS REMARKS:

RECEIVED
NOV - 9 1977

MISS. BU. OF WATER COMMISSIONERS

If well telescopes please sketch and show depths.

GROUND LEVEL

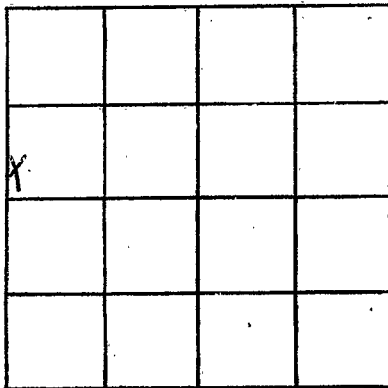

SECTION 32

Please indicate well location X.

ADDITIONAL INFORMATION

If more than one screen, show locations of each on sketch.