

Lincoln  
 1 K 2013  
 6-23-77

MISSISSIPPI  
 BOARD OF WATER COMMISSIONERS  
 416 North State Street  
 Jackson, Mississippi 39201

WATER WELL DRILLERS LOG

June 23 1977 Covington Lincoln  
 date well completed firm name county well located

LANDOWNER: Case  
 Brooker Mrs.  
 (mailing address)

WELL LOCATION:  
 sec. 9 T 6 N R 6 E  
 13 miles W of Brookhaven  
 (distance) (direction) (nearest town)

WELL PURPOSE: Home  
 (home, irrigation, municipal, industrial)

WELL COMPLETION DATA:  
 (1) diameter (inches) 4  
 (2) total depth (feet) 114  
 (3) static water level (feet) 71 below top of ground.  
 (4) casing Plastic 104 (material) (depth)  
 4" (size) if telescope see back.  
 (5) screen 10 104 (length) (depth to top)  
 4" Plastic (size) (material)  
 (6) pump 1/2 6 (HP) (yield gpm)  
 (type power)  
 (7) electric log No (yes or no)  
 (organization running log)  
 (8) how well bottom plugged Wood


description of formations encountered	from	to
CLAY	0	20
SAND	30	22
DIPE CLAY	22	66
Rocky SAND	66	100
SAND	100	114

DRILLERS REMARKS:

RECEIVED  
 AUG 10 1977

If well telescopes please sketch and show depths.

GROUND LEVEL

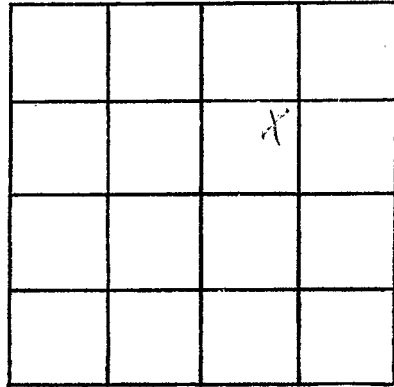

SECTION 9

Please indicate well location X.

ADDITIONAL INFORMATION

If more than one screen,  
show locations of each on sketch.