

LINCOLN

K 2015

4/3/78

April 3
March 30

MISSISSIPPI
BOARD OF WATER COMMISSIONERS
416 North State Street
Jackson, Mississippi 39201

WATER WELL DRILLERS LOG

1978 Grenn Water Well Contractor Lincoln
date well completed firm name county well located


LANDOWNER: <u>David Jordan</u> 961 S. Church Ext. Brookhaven, Miss. (mailing address)	description of formations encountered Citronelle	from 1	to 48
WELL LOCATION:			
sec. <u>12</u> T. <u>6</u> N R. <u>6</u> E # #			
<u>7</u> miles <u>SW</u> of <u>Brookhaven</u> (distance) (direction) (nearest town)			
WELL PURPOSE: <u>home</u> (home, irrigation, municipal, industrial)			
WELL COMPLETION DATA:			
(1) diameter (inches) <u>6</u>			
(2) total depth (feet) <u>49</u>			
(3) static water level (feet) <u>25</u> below top of ground. above			
(4) casing <u>PVC</u> , <u>36</u> (material) (depth)			
<u>4"</u> If telescope see back. (size)			
(5) screen <u>12'</u> , <u>36'</u> (length) (depth to top)			
<u>.010</u> <u>PVC</u> (size) (material)			
(6) pump <u>1/3 HP</u> <u>sub</u> <u>10</u> (HP) (yield gpm)			
<u>electricity</u> (type power)			
(7) electric log <u>no</u> (yes or no)			
(organization running log)			
(8) how well bottom plugged <u>back was in valve</u>			
DRILLERS REMARKS:			

RECEIVED
APR 17 1978

MISS. BD. OF WATER COMM

If well telescopes please sketch and show depths.

GROUND LEVEL

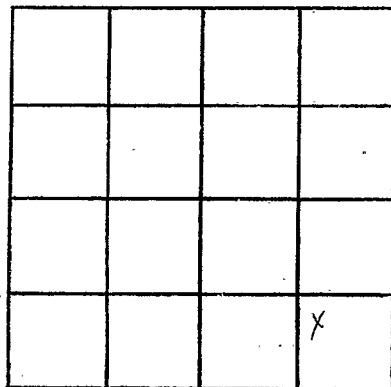

SECTION 12

Please indicate well location X.

ADDITIONAL INFORMATION

If more than one screen,
show locations of each on sketch.