

LINCOLN

K 2016

5-29-78

MISSISSIPPI BOARD OF WATER COMMISSIONERS 416 North State Street Jackson, Mississippi 39201

WATER WELL DRILLERS LOG

May 29 1978 date well completed

Reamus Miller firm name

Lincoln county well located

LANDOWNER:	description of formations encountered	from	to
A. J. Allen	clay	0	14
At Mc Call Creek (mailing address)	red sand	14	58
	gravel & sand	58	63
	pink chert	63	68
	sand	68	80
	gravel	80	85

WELL LOCATION:  
 sec. 16 T. 6 N R. 6 E  
 3 miles west of west Lincoln  
 (distance) (direction) (nearest town)

WELL PURPOSE: home  
 (home, irrigation, municipal, industrial)

WELL COMPLETION DATA:

(1) diameter (inches) 4

(2) total depth (feet) 85

(3) static water level (feet) 63 below top of ground.

(4) casing plastic, bottom (material) (depth)

(size) if telescope see back.

(5) screen 5" 90' (length) (depth to top)

4" plastic (size) (material)

(6) pump 1/2 hp 10 (HP) (yield gpm)

elect (type power)

(7) electric log no (yes or no)

(organization running log)

(8) how well bottom plugged  
 No other plug


DRILLERS REMARKS:

RECEIVED AUG 28 1978

MISS. BD. OF WATER COMM

If well telescopes please sketch and show depths.

GROUND LEVEL

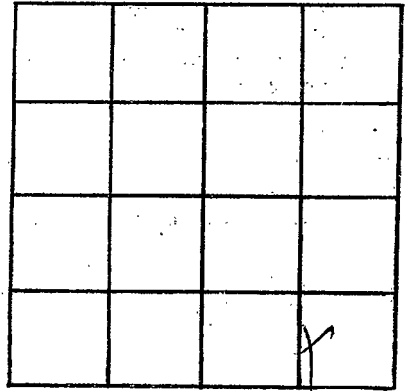

SECTION 16

Please indicate well location X.

ADDITIONAL INFORMATION

If more than one screen,  
show locations of each on sketch.