

LINCOLN
K
10-17-78
2018

MISSISSIPPI
BOARD OF WATER COMMISSIONERS
416 North State Street
Jackson, Mississippi 39201

WATER WELL DRILLERS LOG

10-17-78 date well completed 1978 Filgorell well firm name Lincoln county well located


LANDOWNER:	description of formations encountered	from	to
Carnel Dixon	Red clay	0	20
P.R. Bazwalth (mailing address)	Red sand	20	60
WELL LOCATION:	Blue chalk	60	195
sec. <u>26</u> T. <u>6</u> N. R. <u>6</u> E S W <u>8</u> miles <u>N</u> of <u>Cambur</u> (distance) (direction) (nearest town)	Coarse sand gravel	195	210
WELL PURPOSE: <u>Home</u> (home, irrigation, municipal, industrial)			
WELL COMPLETION DATA:			
(1) diameter (inches) <u>4</u>			
(2) total depth (feet) <u>206</u>			
(3) static water level (feet) <u>100</u> below above top of ground.			
(4) casing <u>PVC</u> , <u>198</u> , (material) (depth)			
<u>4</u> if telescope see back. (size)			
(5) screen <u>8</u> , <u>198</u> (length) (depth to top)			
<u>4</u> , <u>PVC</u> (size) (material)			
(6) pump <u>1/2</u> , <u>10</u> (HP) (yield gpm)			
<u>elec</u> (type power)			
(7) electric log <u>no</u> (yes or no)			
(organization running log)			
(8) how well bottom plugged <u>good block</u>			
DRILLERS REMARKS:			

RECEIVED
DEC - 7 1978

MISS. BD. OF WATER COMM

If well telescopes please sketch and show depths.

GROUND LEVEL

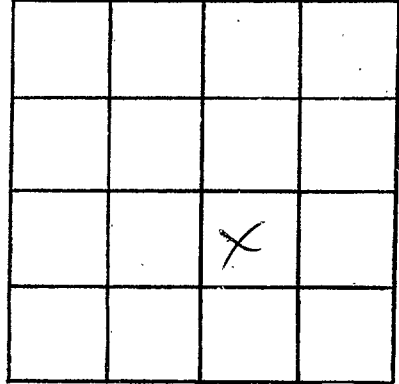

SECTION 26

Please indicate well location X.

ADDITIONAL INFORMATION

A series of horizontal lines for writing additional information.

If more than one screen, show locations of each on sketch.