

LINCOLN
K
1-09-79
2022

**MISSISSIPPI
BOARD OF WATER COMMISSIONERS**
416 North State Street
Jackson, Mississippi 39201

WATER WELL DRILLERS LOG

Jan. 9 1979 Gremm Water Well Cont. Lincoln

date well completed 1979 firm name Gremm Water Well Cont. county well located Lincoln

LANDOWNER:	description of formations encountered	from	to
James O. Magee	Citronelle	1	84
Rt. 2, Box 281			
Brookhaven, Ms. 39601			
(mailing address)			
WELL LOCATION:			
sec. 10 T 6 N R 6 E			
6 SW Brookhaven			
(distance) miles (direction) of (nearest town)			
WELL PURPOSE: home			
(home, irrigation, municipal, industrial)			
WELL COMPLETION DATA:			
(1) diameter (inches) 4			
(2) total depth (feet) 84			
(3) static water level (feet) 65 = below top of ground.			
(4) casing PVC 72			
4" (material) (depth)			
(size) If telescope see back.			
(5) screen 12' 72'			
(length) (depth to top)			
.010 PVC			
(size) (material)			
(6) pump did not install			
(HP) (yield gpm)			
(type power)			
(7) electric log no			
(yes or no)			
(organization running log)			
(8) how well bottom plugged			
back wash valve			
DRILLERS REMARKS:			


Miss. Board of Water Comm.

FEB 14 1979

RECEIVED

If well telescopes please sketch and show depths.

GROUND LEVEL

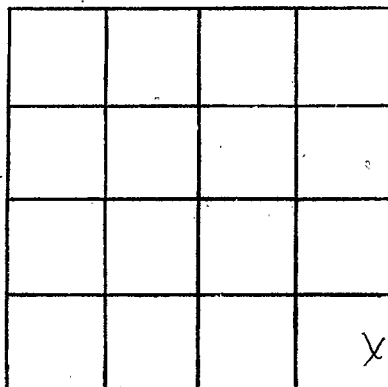

SECTION 10

Please indicate well location X.

ADDITIONAL INFORMATION

If more than one screen,
show locations of each on sketch.