

Lincoln
K 2023
8-13-80

MISSISSIPPI
 BOARD OF WATER COMMISSIONERS
 416 North State Street
 Jackson, Mississippi 39201

WATER WELL DRILLERS LOG


Aug. 13 1980 Grenn Water Well Cont. Lincoln
 date well completed firm name county well located

LANDOWNER:	description of formations encountered	from	to
David Mosely	clay	1	5
Route 5, Box 120 M2	white clay	5	30
Brookhaven, Miss.	blue clay	30	50
(mailing address)	white clay	50	65
WELL LOCATION:	fine sand	65	75
n sec. 9 T. 6N R. 6E	blue clay	75	80
11 miles SW of Brookhaven	sand	80	105
(distance) (direction) (nearest town)			
WELL PURPOSE: home			
(home, irrigation, municipal, industrial)			
WELL COMPLETION DATA:			
(1) diameter (inches) 4			
(2) total depth (feet) 105			
(3) static water level (feet) 55 below top of ground.			
(4) casing PVC 95' (material) (depth)			
4" (size) if telescope see back.			
(5) screen 10' 95' (length) (depth to top)			
.010 PVC (size) (material)			
(6) pump 1/2 sub 8 (HP) (yield gpm)			
electricity (type power)			
(7) electric log no (yes or no)			
(organization running log)			
(8) how well bottom plugged back wash valve			
DRILLERS REMARKS:			

DEPT. OF NATURAL RESOURCES
 BUREAU OF LAND & WATER RESOURCES
 OCT 23 1980
 RECEIVED

If well telescopes please sketch and show depths.

GROUND LEVEL

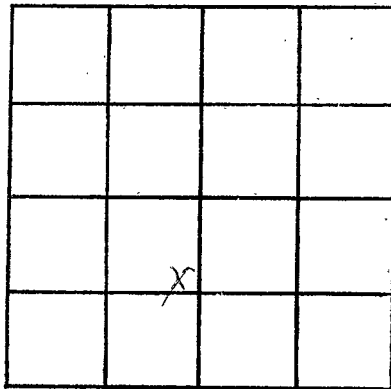

SECTION 11

Please indicate well location X.

ADDITIONAL INFORMATION

If more than one screen,
show locations of each on sketch.