

MISSISSIPPI DEPARTMENT OF NATURAL RESOURCES

Bureau of Land and Water Resources

Southport Mall

P.O. Box 10631

Jackson, Mississippi 39209

WATER WELL DRILLERS LOG

Lincoln
K 2024
10-13-79

date well completed Oct 13 1979 firm name Reems Well Drilling county well located Lincoln

LANDOWNER:
Solon Freeman
H. Bogue Chitto
 (mailing address)

description of formations encountered	from	to
<u>Red Clay</u>	<u>0</u>	<u>12</u>
<u>Sand</u>	<u>12</u>	<u>46</u>
<u>Gravel & Sand</u>	<u>46</u>	<u>55</u>

WELL LOCATION:
 sec. 25 T-6 N R-6 E
8 miles W. NW of Bogue Chitto
 (distance) (direction) (nearest town)

WELL PURPOSE: Trailer
 (home, irrigation, municipal, industrial)

- WELL COMPLETION DATA:
- (1) diameter (inches) 4"
 - (2) total depth (feet) 55'
 - (3) static water level (feet) 40 below top of ground.
 - (4) casing Plastic bottom
 (material) (depth)
 - if telescope see back.
 (size)
 - (5) screen 5' 50'
 (length) (depth to top)
 - 4" Plastic
 (size) (material)
 - (6) pump by other's
 (HP) (yield gpm)
 - Electric
 (type power)
 - (7) electric log no
 (yes or no)
 - (organization running log)
 - (8) how well bottom plugged water plug

DRILLERS REMARKS:
[Signature]


DEPT. OF NATURAL RESOURCES
 BUREAU OF LAND & WATER RESOURCES

OCT - 9 1980

RECEIVED

If well telescopes please sketch and show depths.

GROUND LEVEL

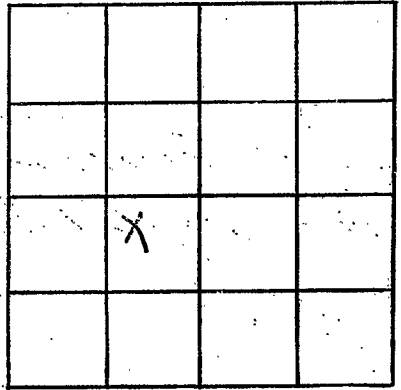

SECTION 25

Please indicate well location X.

ADDITIONAL INFORMATION

If more than one screen,
show locations of each on sketch.