

Lincoln
K 2025
1/14/81

MISSISSIPPI
 BOARD OF WATER COMMISSIONERS
 416 North State Street
 Jackson, Mississippi 39201

WATER WELL DRILLERS LOG

Jan. 14 1981 81 Grenn Water Well Cont. Lincoln
 date well completed firm name county well located

LANDOWNER: Felder Hartzog
 P.O. Box 37
 McCall Creek, Ms.
 (mailing address)

description of formations encountered	from	to
clay	1	10
sand & gravel	10	18
white clay	18	29
blue clay	29	70
white clay	70	80
sand	80	118

WELL LOCATION:
 sec 9 T 6 N R 6 E
 S W
8 miles SW of Brookhaven
 (distance) (direction) (nearest town)

WELL PURPOSE: home
 (home, irrigation, municipal, industrial)


WELL COMPLETION DATA:
 (1) diameter (inches) 4
 (2) total depth (feet) 108
 (3) static water level (feet) 50 below top of ground.
 (4) casing PVC 108
 (material) (depth)
4" if telescope see back.
 (size)
 (5) screen 10' 108'
 (length) (depth to top)
.010 PVC
 (size) (material)
 (6) pump 1/2 sub 8
 (HP) (yield gpm)
electricity
 (type power)
 (7) electric log no
 (yes or no)
 (organization running log)
 (8) how well bottom plugged
back wash valve

DRILLERS REMARKS:

MISSISSIPPI BOARD OF WATER COMMISSIONERS
 BUREAU OF WATER RESOURCES
 JAN 20 1981
 RECEIVED

If well telescopes please sketch and show depths.

GROUND LEVEL

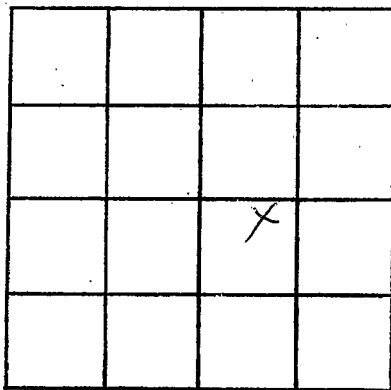

SECTION 9

Please indicate well location X.

ADDITIONAL INFORMATION

If more than one screen,
show locations of each on sketch.