

Lincoln
 K 2026
 5-12-80
 May 12 1980
 date well completed

MISSISSIPPI
 BOARD OF WATER COMMISSIONERS
 416 North State Street
 Jackson, Mississippi 39201

WATER WELL DRILLERS LOG

80 Rivers Well Sec
 firm name
 Lincoln
 county well located

LANDOWNER:
 Selon Freeman
 Rt 5 Brookhaven
 (mailing address)

description of formations encountered	from	to
Red Clay	0	12
sand & gravel	12	50

WELL LOCATION:
 sec. 25 T. 4 N R. 6 E
 6 1/2 miles N. NW of Bogalusa
 (distance) (direction) (nearest town)

WELL PURPOSE: Trailer
 (home, irrigation, municipal, industrial)

- WELL COMPLETION DATA:
- (1) diameter (inches) 4"
 - (2) total depth (feet) 50'
 - (3) static water level (feet) 12' below top of ground.
 - (4) casing plastic bottom
 (material) (depth)
 - if telescope see back.
 (size)
 - (5) screen 5' 4.5'
 (length) (depth to top)
 - 1" plastic
 (size) (material)
 - (6) pump by other
 (HP) (yield gpm)
 - stut
 (type power)
 - (7) electric log no
 (yes or no)
 - (organization running log)

(8) how well bottom plugged
back wash valve

DRILLERS REMARKS:
—


DEPT. OF NATURAL RESOURCES
 BUREAU OF LAND & WATER RESOURCES

FEB 2 - 1981

RECEIVED

If well telescopes please
sketch and show depths.

GROUND LEVEL

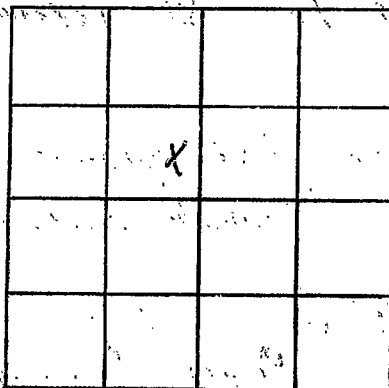

SECTION 25

Please indicate well location X.

ADDITIONAL INFORMATION

If more than one screen,
show locations of each on sketch.