

Lincoln
K2027
3-17-81

MISSISSIPPI
 BOARD OF WATER COMMISSIONERS
 416 North State Street
 Jackson, Mississippi 39201

WATER WELL DRILLERS LOG

March 17, 1981 Grenn Water Well Cont. Lincoln
 date well completed firm name county well located

LANDOWNER:	description of formations encountered	from	to
Bateman Stillely	Clay	1	20
Route 5, Box 130 JZ	sand & gravel	20	55
Brookhaven, Ms.	white clay	55	75
(mailing address)	blue clay	75	100
WELL LOCATION:	white clay	100	110
sec. <u>9</u> T. <u>6</u> N R. <u>6</u> E	sand	110	150
SW S W			
<u>9</u> miles SW of Brookhaven			
(distance) (direction) (nearest town)			
WELL PURPOSE: <u>home</u>			
(home, irrigation, municipal, industrial)			
WELL COMPLETION DATA:			
(1) diameter (inches) <u>4</u>			
(2) total depth (feet) <u>155</u>			
(3) static water level (feet) <u>100</u> below above top of ground.			
(4) casing <u>PVC</u> , <u>145</u>			
(material) (depth)			
<u>4"</u> if telescope see back.			
(size)			
(5) screen <u>10"</u> , <u>145</u>			
(length) (depth to top)			
<u>.010</u> , <u>PVC</u>			
(size) (material)			
(6) pump <u>3/4</u> sub <u>8</u>			
(HP) (yield gpm)			
<u>electricity</u>			
(type power)			
(7) electric log <u>no</u>			
(yes or no)			
(organization running log)			
(8) how well bottom plugged			
<u>back wash valve</u>			
DRILLERS REMARKS:			


DEPT. OF NATURAL RESOURCES
 BUREAU OF LAND & WATER RESOURCES

JUN 5 - 1981

RECEIVED

If well telescopes please sketch and show depths.

GROUND LEVEL

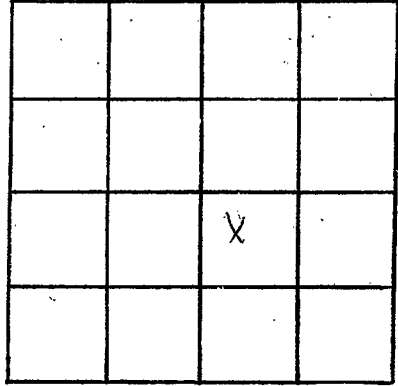

SECTION 9

Please indicate well location X.

ADDITIONAL INFORMATION

If more than one screen, show locations of each on sketch.