

LINCOLN  
 K 2029  
 9/20/77

MISSISSIPPI  
 BOARD OF WATER COMMISSIONERS  
 416 North State Street  
 Jackson, Mississippi 39201

(128)

WATER WELL DRILLERS LOG

*Sinclair*

9-20  
 date well completed

1977 *Rever Miller*  
 firm name

*Lincoln*  
 county well located

LANDOWNER:  
*Harvard Richardson*  
*Rt. Meadville*  
 (mailing address)

description of formations encountered	from	to
<i>Red sand clay</i>	<i>0</i>	<i>30</i>
<i>blue chalk</i>	<i>30</i>	<i>125</i>
<i>Coarse sand</i>	<i>125</i>	<i>153</i>

WELL LOCATION:  
 sec. *10* T. *6* N. R. *6* E  
*10* miles *W-SW* of *Bradley*  
 (distance) (direction) (nearest town)

WELL PURPOSE: *home*  
 (home, irrigation, municipal, industrial)

- WELL COMPLETION DATA:
- (1) diameter (inches) *4"*
  - (2) total depth (feet) *153*
  - (3) static water level (feet) *110* below above top of ground
  - (4) casing *plastic pvc*  
 (material) (depth)
  - if telescope see back.  
 (size)
  - (5) screen *10'* *143'*  
 (length) (depth to top)
  - 1 1/2"* *plastic*  
 (size) (material)
  - (6) pump *1 1/2* *200*  
 (HP) (yield gpm)
  - slut*  
 (type power)
  - (7) electric log *no*  
 (yes or no)
- (organization running log)

(8) how well bottom plugged  
*wooden plug*


DRILLERS REMARKS:  
*[Signature]*

RECEIVED  
 FEB 21 1978

MISS. BD. OF WATER COMMISSIONERS

If well telescopes please sketch and show depths.

GROUND LEVEL

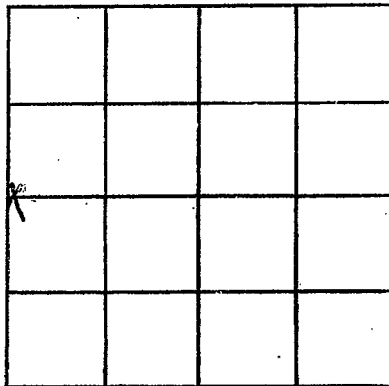

SECTION 10

Please indicate well location X.

ADDITIONAL INFORMATION

If more than one screen, show locations of each on sketch.