


MISSISSIPPI DEPARTMENT OF NATURAL RESOURCES
 Bureau of Land and Water Resources
 Southport Mall
 P.O. Box 10631
 Jackson, Mississippi 39209
WATER WELL DRILLERS LOG

Lincoln
PK
2-10-81
2030


MAKEN 2/10/81 91 Gretn Water Well Cont. Lincoln
 date well completed firm name county well located

LANDOWNER:	Description of formations encountered	from	to
<u>Howard Richardson</u>	<u>clay</u>	<u>1</u>	<u>18</u>
<u>Route 5, Box 128</u>	<u>sand & gravel</u>	<u>18</u>	<u>35</u>
<u>Brookhaven, Ms.</u>	<u>white clay</u>	<u>35</u>	<u>45</u>
<u>(mailing address)</u>	<u>blue clay</u>	<u>45</u>	<u>120</u>
WELL LOCATION:	<u>white clay</u>	<u>120</u>	<u>140</u>
sec. <u>9</u> T. <u>6</u> N. R. <u>6</u> E	<u>sand</u>	<u>140</u>	<u>195</u>
<u>9</u> miles SW of <u>Brookhaven</u>			
<u>(distance)</u> (direction) of <u>(nearest town)</u>			
WELL PURPOSE: <u>home</u>			
<u>(home, irrigation, municipal, industrial)</u>			
WELL COMPLETION DATA:			
(1) diameter (inches) <u>4</u>			
(2) total depth (feet) <u>195</u>			
(3) static water level (feet) <u>105</u> below top of ground.			
(4) casing <u>PVC</u> , <u>185</u>			
(material), (depth)			
• <u>4"</u> if telescope see back.			
(size)			
(5) screen <u>10'</u> , <u>185'</u>			
(length), (depth to top)			
• <u>010</u> , <u>PVC</u>			
(size), (material)			
(6) pump <u>3/4</u> sub <u>10</u>			
(HP) (yield gpm)			
<u>electricity</u>			
(type power)			
(7) electric log <u>no</u>			
(yes or no)			
<u>(organization running log)</u>			
(8) how well bottom plugged <u>back wash valve</u>			
DRILLERS REMARKS:			

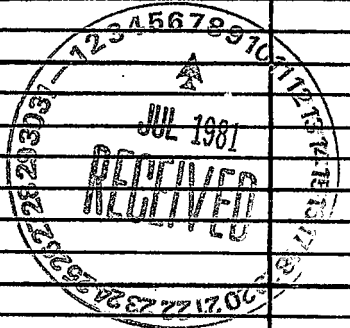

If well telescopes please sketch and show depths.

GROUND LEVEL

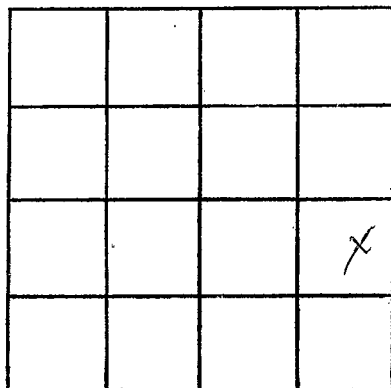

SECTION 9

Please indicate well location X.

ADDITIONAL INFORMATION

If more than one screen,
show locations of each on sketch.